

OCT 28 1994

LAND CORNER RECORDATION CERTIFICATE

Filing Requirement of Act 74, Mich. P.A. 1970

STATE OF MICHIGAN COUNTY OF KENT RECEIVED FOR RECORD

94 AUG 24 AM 11:52

For corners in COMMISSION

Kent

(County)

Located In:

Algoma Twp. Corner Code #

- 1. Public Land Survey T 9N R 11W H-12
T ___ R ___ Center Sec. 34
T ___ R ___
T ___ R ___
- 2. Property Controlling S ___ T ___ R ___
in Section S ___ T ___ R ___
Property in Sec. S ___ T ___ R ___
- 3. Miscellaneous S ___ T ___ R ___
Property in Sec. S ___ T ___ R ___

W. J. Bond
REG. OF DEEDS

6976

Register of Deeds Stamp & File Number

- 4. Lot No. _____, Recorded Plat _____
- 5. Private Claims _____

A	B	C	D	E	F	G	H	I	J	K	L	M
2	6		5		4		3		2		1	
3												
4	7		8		9		10		11		12	
5												
6	18		17		16		15		14		13	
7												
8	19		20		21		22		23		24	
9												
10	30		29		28		27		26		25	
11												
12	31		32		33		▲		35		36	
13												

I, Wallace E. Glaza, in a field survey on August 1, 1994, do hereby certify that under requirements of P.A. 74, Michigan P.A. of 1970, the corner points mentioned in lines 1 and 2 above were in conformance with regulations and rules therefore as required in the current manual of survey instructions of the United States Department of the Interior, Bureau of Land Management or by a decree of a Court of Law and/or that the corner points mentioned in lines 3, 4 and 5 above were in conformance with the rules of the Michigan Board of Land Surveyors or by a Decree of a Court of Law; established, re-established, monumented, re-monumented, recovered, found as expressed below:

NOTE: Not more than 4 corners, all in the same town and range, may be recorded on this certificate.

A. Description of original monument and accessories and/or subsequent restoration:

Kent County Road Commission witnesses
Leaded Stone
31" Maple WSW 25.96'
16" Cherry N 18.42'
7" dead Pine NE 13.08'
MSHD - 1964

Williams & Works (4/27/50)
Found and accepted leaded stone
at intersection of 1/4 line fences.

B. Description of corner evidence found and/or method applied in restoring or reestablishing corner:

H-12 (Center of Section 34, T9N, R11W, Algoma Township, Kent County, Michigan)

Found leaded stone. N-S fence line 1.4' West. Fence to West 1.1' North. Leaded stone is 5.36' North & 1.04' East of the intersection of the 1/4 lines. Replaced leaded stone with standard 4" x 30" Kent County monument. (Harrison)


- West 1/4 corner to Center - 2654.37'
- North 1/4 corner to Center - 2656.83'
- East 1/4 corner to Center - 2668.74'
- South 1/4 corner to Center - 2663.27'

P.A. 345 1930 KENT COUNTY
PEER APPROVED 7/28/94
CHAIRMAN *Harry Huber*

C. Description of monument for corner and accessories established to perpetuate locating the position of the corner:

H-12 (4" x 30" Kent County monument)

- 1) Remon tag & nail in W. side 20" Beech N00°E 18.14'
- 2) Remon tag & nail in SW side 14" Beech N48°W 41.97'
- 3) Remon tag & nail in W. side 16" Maple S08°E 37.43'
- 4) Remon tag & nail in SE side 12" twin Maple S48°W 27.18'
- 5) Moved leaded stone 2'± South

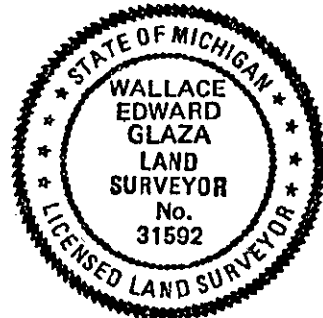

Signed by Wallace E. Glaza
Glaza and Associates, Inc.
Surveyor's Michigan License No. 31592

Date August 4, 1994