

SURVEY & REMONUMENTATION

MAR 08 1998

KENT COUNTY REMONUMENTATION

\$7.00
\$2.00

SECTION LAND CORNER RECORDATION CERTIFICATE
Filing Requirement of Act 74, Mich. P.A. 1970

For corners in

KENT COUNTY (County)	Located In:	Corner Code #
1. Public Land Survey	T 9N R 11W	I-2
	T R	
	T R	
	T R	
2. Property Controlling in Section	S T R	
	S T R	
3. Miscellaneous Property in Sec.	S T R	
	S T R	

STATE OF MICHIGAN
COUNTY OF KENT
REGISTERED FOR RECORD

98 MAR -5 AM 8:38

REG. OF DEEDS

Handwritten Signature


10545

Register of Deeds Stamp & File Number

4. Lot No. _____, Recorded Plat _____
 5. Private Claims _____

I, Kirk Breitels, in a field survey on Jan. 7, 1998 do hereby state that under requirements of P.A. 74, Michigan P.A. of 1970, the corner points mentioned in lines 1 and 2 above were in conformance with regulations and rules therefore as required in the current manual of survey instructions of the United States Department of the Interior, Bureau of Land Management or by a decree of a Court of Law and/or that the corner points mentioned in lines 3, 4 and 5 above were in conformance with the rules of the Michigan Board of Land Surveyors or by a Decree of a Court of Law; established, re-established, monumented, recovered, found as expressed below:

NOTE: Not more than 2 corners, all in the same town and range, may be recorded on this certificate.

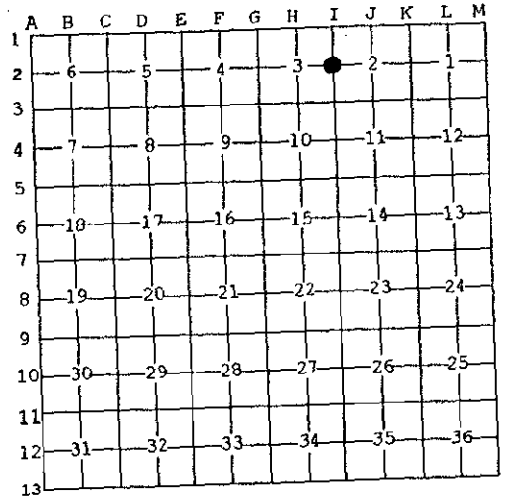

A. Description of original monument and accessories and/or subsequent restoration:

I-2	1837	GLO	Whitcomb	Set Post
	1966	Kent Co. Wits		Iron in Mon. Box
	1976	LCRC #1010	Nederveld	Mon. Box
	1980	LCRC #1338	Hackbardt	Mon. Box
	1982	LCRC #2511	Starr	Set Kent County Monument in Mon. Box
	1994	LCRC #7023	Byl	Kent County Monument

The position of this corner was previously approved by the Kent County Remonumentation Peer Group, monumented by Thomas C. Starr on 1-5-82 and was recorded per LCRC #2511.

P.A. 345 1990 KENT COUNTY
 PEER APPROVED 2/19/98
 CHAIRMAN *Handwritten Signature*

B. Description of corner evidence found and/or method applied in restoring or reestablishing corner:

I-2 Found Kent County Monument (Harrison) per witnesses from above LCRC as set by Thomas C. Starr in place of the 1" Iron Pipe he found inside a Mon. Box. Said 1" Iron Pipe checks with Kent Co. Wits. and LCRC's #1010 & #1338.

LCRC #2511		LCRC #7023	
Nail & Remon. tag 32" Oak North	58.37'	Nail & Remon. tag 38" Oak	N00°E 58.34'
Nail & Remon. tag 30" Oak N70°E	56.75'	Nail & Remon. tag 36" Oak	N70°E 56.70'
Nail & Remon. tag P. Pole	S70°W 93.35'	Nail & Remon. tag P. Pole	S70°W 93.33'
Nail & Remon. tag 14" Maple	S20°W 96.89'	Nail & Remon. tag 18" Maple	S20°W 96.51'
Nail & Remon. tag 26" Oak	S10°E 142.86'	Nail & Remon. tag 30" Oak	S10°E 142.84'
Nail & Remon. tag 18" Tree	S75°E 118.22'	Nail & Remon. tag 24" Pear Tree	S75°E 118.22'

The selected location is accepted by me and is generally accepted by professional surveyors as the best available evidence of the position of the original corner.

C. Description of monument for corner and accessories established to perpetuate locating the position of the corner:

I-2 Standard Kent County Monument	
Nail & KC Remon. tag W. side 38" Oak	N00°E 58.34'
Nail & KC Remon. tag S. side 36" Oak	N70°E 56.70'
Nail & KC Remon. tag N. side P. Pole	S70°W 96.33'
Nail & KC Remon. tag E. side 18" Maple	S20°W 96.84'
Nail & KC Remon. tag W. side 30" Oak	S10°E 142.84'
Nail & KC Remon. tag N. side 24" Pear Tree	S75°E 118.22'



Signed by *Kirk Breitels*
 Surveyor's Michigan License No. 30077

Date 2/19/98