

\$7.00
\$2.00

MAR 08 1999

KENT COUNTY REMONUMENTATION

SECTION _____

LAND CORNER RECORDATION CERTIFICATE Filing Requirement of Act 74, Mich. P.A. 1970

For corners in

KENT COUNTY
(County)

Located In:	Corner Code #
T <u>9N</u> R <u>11W</u>	<u>I-5</u>
T _____ R _____	_____
T _____ R _____	_____
T _____ R _____	_____
S _____ T _____ R _____	_____
S _____ T _____ R _____	_____
S _____ T _____ R _____	_____
S _____ T _____ R _____	_____

- 1. Public Land Survey
- 2. Property Controlling in Section
- 3. Miscellaneous Property in Sec.

- 4. Lot No. _____, Recorded Plat _____
- 5. Private Claims _____

STATE OF MICHIGAN
COUNTY OF KENT
RECEIVED FOR RECORD

98 MAR -5 AM 8:34

REG. OF DEEDS


Lucy Bond

10547

Register of Deeds Stamp & File Number

I, Kirk Breitels, in a field survey on Jan. 19, 19 98 do hereby state that under requirements of P.A. 74, Michigan P.A. of 1970, the corner points mentioned in lines 1 and 2 above were in conformance with regulations and rules therefore as required in the current manual of survey instructions of the United States Department of the Interior, Bureau of Land Management or by a decree of a Court of Law and /or that the corner points mentioned in lines 3, 4 and 5 above were in conformance with the rules of the Michigan Board of Land Surveyors or by a Decree of a Court of Law, established, re-established, monumented, recovered, found as expressed below:

NOTE: Not more than 2 corners, all in the same town and range, may be recorded on this certificate.

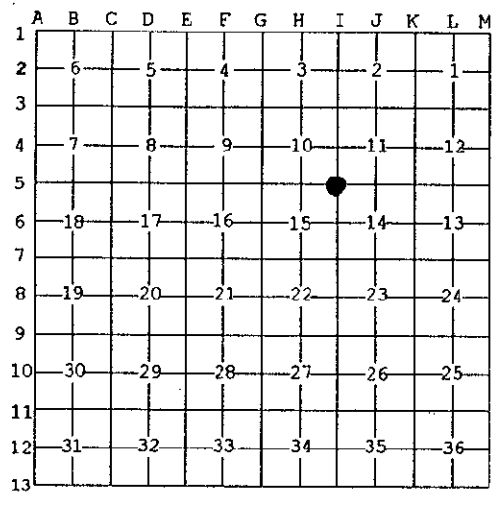

A. Description of original monument and accessories and/or subsequent restoration:

- I-5 1837 GLO Whitcomb Set Post
- 1942-70 Williams & Works Mon. Box
- 1964 Kent Co. Wits "T" Iron ??
- Moore & Bruggink Mon. Box
- 1984 LCRC #3785 Byl Set Kent County Monument in Mon. Box
- 1994 LCRC #7026 Byl Kent County Monument

P.A. 345 1990 KENT COUNTY
PEER APPROVED 2/19/98
CHAIRMAN Wampfler

The position of this corner was previously approved by the Kent County Remonumentation Peer Group, monumented by William R. Byl on 3-29-84 and was recorded per LCRC #3785.

B. Description of corner evidence found and/or method applied in restoring or reestablishing corner:

I-5 Found Kent County Monument (Harrison) per witnesses from above LCRC as set by William R. Byl in place of the 1" Iron Pipe he found inside a Mon. Box. Said Iron checks with Williams & Works and Moore & Bruggink. Kent Co. Wits. may be for a different corner.

LCRC #3785	LCRC #7026
SW cor. conc. blk. porch fnd. N60°E 100.50'	SW cor. conc. blk. porch fnd. N60°E 100.54'
Nail & Remon. tag P. Pole N65°E 76.40'	Nail & Remon. tag P. Pole N65°E 76.40'
Nail & Remon. tag P. Pole S15°E 70.55'	Nail & Remon. tag P. Pole S15°E 72.55'
Nail & Remon. tag 6" Oak S45°W 75.20'	Nail & Remon. tag 10" Oak S45°W 69.99'
	Nail & Remon. tag top guard rail post N80°W 146.19'

The selected location is accepted by me and is generally accepted by professional surveyors as the best available evidence of the position of the original corner.

C. Description of monument for corner and accessories established to perpetuate locating the position of the corner:

- I-5 Standard Kent County Monument
- SW corner conc. block porch foundation N60°E 100.54'
- Nail & KC Remon. tag N. side P. Pole N65°E 76.35'
- Nail & KC Remon. tag W. side P. Pole S15°E 72.55'
- Nail & KC Remon. tag NW side 12" Oak S45°W 69.97'
- Nail & KC Remon. tag SW side fence post N30°W 63.65'



Signed by *Kirk Breitels*
Surveyor's Michigan License No. 30077

Date 2/19/98