SURVEY & REMONUMENTATION

$7.00
$2.00

MAR 0 8 1999

SECTION

KENT COUNTY REMONUMENTATION

LAND CORNER RECORDATION CERTIFICATE
Filing Requirement of Act 74, Mich. P.A. 1970

STATE OF MICHIGAN
COUNTY OF KENT
RECEIVED FOR RECORD
98 MAR -5 AM 8: 34
REG. OF DEEDS

10564
Register of Deeds Stamp & File Number

For corners in

KENT COUNTY
(County)

	Located In:		Corner Code #
1. Public Land Survey		T 9N R 11W	K-7
		T___ R___	
		T___ R___	
		T___ R___	
2. Property Controlling in Section	S___	T___ R___	
	S___	T___ R___	
3. Miscellaneous Property in Sec.	S___	T___ R___	
	S___	T___ R___	

4. Lot No. _____ , Recorded Plat _____
5. Private Claims _____

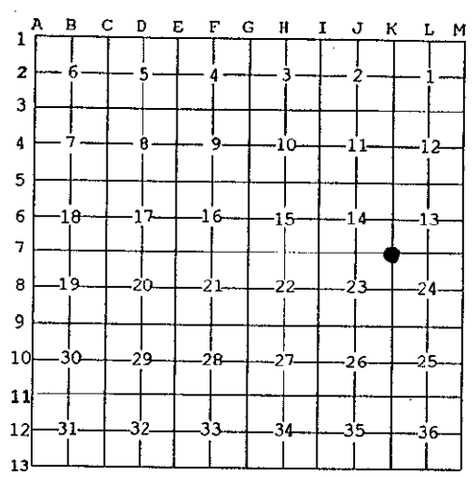

I, Kirk Breitels, in a field survey on Jan. 19, 19 98 do hereby state that under requirements of P.A. 74, Michigan P.A. of 1970, the corner points mentioned in lines 1 and 2 above were in conformance with regulations and rules therefore as required in the current manual of survey instructions of the United States Department of the Interior, Bureau of Land Management or by a decree of a Court of Law and /or that the corner points mentioned in lines 3, 4 and 5 above were in conformance with the rules of the Michigan Board of Land Surveyors or by a Decree of a Court of Law; established, re-established, monumented, recovered, found as expressed below:

NOTE: Not more than 2 corners, all in the same town and range, may be recorded on this certificate.

A. Description of original monument and accessories and/or subsequent restoration:

K-7	1837	GLO	Whitcomb	Set Post
	1964	Kent Co. Wits		Mon. Box
	1975	LCRC #884	Nederveld	Iron in Mon. Box
	1981	LCRC #2553	Bueche	Set Kent County Monument in Mon. Box
	1994	LCRC #7046	Byl	Kent County Monument

P.A. 345 1990 KENT COUNTY
PEER APPROVED 2/19/98
CHAIRMAN Harry Huber

The position of this corner was previously approved by the Kent County Remonumentation Peer Group, monumented by John C. Bueche on 12-21-81 and was recorded per LCRC #2553.

B. Description of corner evidence found and/or method applied in restoring or reestablishing corner:

K-7 Found Kent County Monument (Harrison) per witnesses from above LCRC as set by John C. Bueche in place of the 1" Iron he found inside a Mon. Box. Said Iron checks with Kent Co. Wits. and LCRC #884.

LCRC #2553		LCRC #7046	
Nail & Remon. tag 8" Elm	S60°E 48.49'	"X" cut E. end S. bridge rail	S80°W 56.08'
Nail & Remon. tag guard rail post	N73°E 37.04'	"X" cut E. end N. bridge rail	N70°W 56.14'
Nail & Remon. tag guard rail post	N10°W 14.63'	Nail & Remon. tag top guard rail post	N70°E 39.23'
Nail & MSHD tag P. Pole	S40°E 60.49'	Nail & Remon. tag top guard rail post	N20°W 17.70'
"X" cut E. end S. bridge rail	S80°W 56.12'	Nail & Remon. tag P. Pole	S56°E 160.05'
"X" cut E. end N. bridge rail	N70°W 56.14'	C/L blktp. E-W is South 1' ±	

The selected location is accepted by me and is generally accepted by professional surveyors as the best available evidence of the position of the original corner.

C. Description of monument for corner and accessories established to perpetuate locating the position of the corner:

K-7 Standard Kent County Monument

"X" cut on E. end S. bridge rail (6" above road)	S80°W 56.08'
"X" cut on E. end N. bridge rail (6" above road)	N70°W 56.14'
Nail & KC Remon. tag top of guard rail post	N70°E 39.23'
Nail & KC Remon. tag top of guard rail post	N20°W 17.70'
Nail & KC Remon. tag N. side P. Pole	S56°E 160.05'
C/L blktp. road E-W is South 1' ±	

STATE OF MICHIGAN
KIRK BREITELS
LAND SURVEYOR
NO
30077
LICENSED LAND SURVEYOR

Signed by Kirk Breitels

Date 2/19/98

Surveyor's Michigan License No. 30077

FORM APPROVED BY MICHIGAN STATE BOARD OF PROFESSIONAL SURVEYORS, JAN. 28, 1971
REVISED MAY 14,1975
REVISED JAN., 1983
REVISED OCT., 1995