SURVEY & REMONUMENTATION

7/2

MAR 08 1999

SECTION

KENT COUNTY REMONUMENTATION

LAND CORNER RECORDATION CERTIFICATE
Filing Requirement of Act 74, Mich. P.A. 1970

STATE OF MICHIGAN
COUNTY OF KENT
RECEIVED FOR RECORD
98 OCT -7 AM 10: 15
REG. OF DEEDS

10694

Register of Deeds Stamp & File Number

For corners in KENT COUNTY (County)

	Located In:	Corner Code #
1. Public Land Survey	T9N R11W	L-4
	T___ R___	
	T___ R___	
	T___ R___	
2. Property Controlling	S___ T___ R___	
in Section	S___ T___ R___	
3. Miscellaneous	S___ T___ R___	
Property in Sec.	S___ T___ R___	

4. Lot No. _____ , Recorded Plat _____
5. Private Claims _____

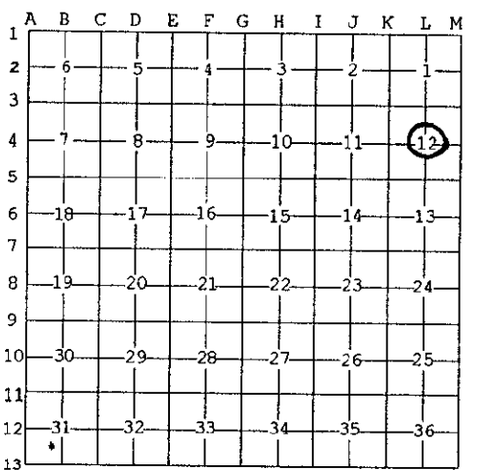

I, Kirk Breitels, in a field survey on June 30, 19 98 do hereby state that under requirements of P.A. 74, Michigan P.A. of 1970, the corner points mentioned in lines 1 and 2 above were in conformance with regulations and rules therefore as required in the current manual of survey instructions of the United States Department of the Interior, Bureau of Land Management or by a decree of a Court of Law and /or that the corner points mentioned in lines 3, 4 and 5 above were in conformance with the rules of the Michigan Board of Land Surveyors or by a Decree of a Court of Law; established, re-established, monumented, recovered, found as expressed below:

NOTE: Not more than 2 corners, all in the same town and range, may be recorded on this certificate.

A. Description of original monument and accessories and/or subsequent restoration:

L-4 1837 GLO — Not Set
1958-74 Williams & Works — Used true center - found monument 0.46' South
1964 Kent Co. Wits — 1" Iron
1974 LCRC #751 Spicer — PK Nail
5" Sassafras S00°E 47.82' 30" Ash S80°W 117.35' 15" Apple N45°W 71.67' Mon. South 0.46'
1975 Survey Exxel — PK Nail - per LCRC #751
1984-89 Surveys Hackbardt — 1" Iron

B. Description of corner evidence found and/or method applied in restoring or reestablishing corner:

L-4 Found PK Nail per remaining witnesses of above LCRC:
C/L 15" Sassafras S00°E 48' C/L 36" Ash S80°W 117'
1" Iron Pipe South 0.46' - this Iron is per Kent Co. Wits. and Hackbardt surveys.

P.A. 345 1990 KENT COUNTY
PEER APPROVED 7/23/98
CHAIRMAN Gary Huber

The PK Nail is 14.9' W. and less than 0.1' S. of intersection of 1/4 lines.

The PK Nail is accepted by me and is generally accepted by professional surveyors as the best available evidence of the position of the corner.

C. Description of monument for corner and accessories established to perpetuate locating the position of the corner:

L-4 Set Standard Kent County Monument in place of the PK Nail

Nail & KC Remon. tag SE side fence post	N50°E	42.09'
Nail & KC Remon. tag NE side P. Pole	S50°E	119.95'
Nail & KC Remon. tag E. side 15" Sassafras	S00°E	47.93'
Nail & KC Remon. tag N. side 36" Ash	S80°W	117.10'
Iron Pipe - South 0.46'		

STATE OF MICHIGAN
KIRK BREITELS
LAND SURVEYOR
NO
30077
LICENSED LAND SURVEYOR

Signed by Kirk Breitels

Date 9/25/98

Surveyor's Michigan License No. 30077

FORM APPROVED BY MICHIGAN STATE BOARD OF PROFESSIONAL SURVEYORS, JAN. 28, 1971
REVISED MAY 14, 1975
REVISED JAN., 1983
REVISED OCT., 1995