~~$7.00~~
$2.00

KENT COUNTY REMONUMENTATION MAINTENANCE

LAND CORNER RECORDATION CERTIFICATE
Filing Requirement of Act 74, Mich. P.A. 1970

STATE OF MICHIGAN
COUNTY OF KENT
RECEIVED FOR RECORD
98 DEC 23 AM 8:59
REG. OF DEEDS

11077
Register of Deeds Stamp & File Number

For corners in
KENT COUNTY
(County)

	Located In:	Corner Code #
1. Public Land Survey	T 9N R 11W	G-13
	T___ R___	
	T___ R___	
	T___ R___	
2. Property Controlling	S___ T___ R___	
in Section	S___ T___ R___	
3. Miscellaneous	S___ T___ R___	
Property in Sec.	S___ T___ R___	

4. Lot No. _____ , Recorded Plat _____
5. Private Claims _____

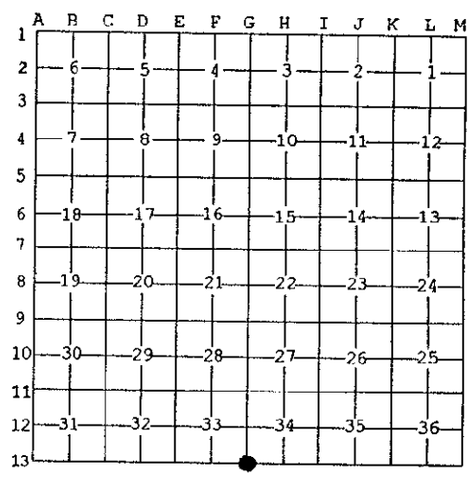

I, Kirk Breitels, in a field survey on Oct. 28, 19 98 do hereby state that under requirements of P.A. 74, Michigan P.A. of 1970, the corner points mentioned in lines 1 and 2 above were in conformance with regulations and rules therefore as required in the current manual of survey instructions of the United States Department of the Interior, Bureau of Land Management or by a decree of a Court of Law and /or that the corner points mentioned in lines 3, 4 and 5 above were in conformance with the rules of the Michigan Board of Land Surveyors or by a Decree of a Court of Law; established, re-established, monumented, recovered, found as expressed below:

NOTE: Not more than 2 corners, all in the same town and range, may be recorded on this certificate.

A. Description of original monument and accessories and/or subsequent restoration:

G-13 Kent County Monument, LCRC #9134, 3/1/96

Nail & KC Remon. tag E. side P. Pole	S00°W	121.17'
Top of South corner of conc. ROW marker	N20°W	97.28'
Top of South corner of conc. ROW marker	N16°E	121.50'
2" Angle Iron fence corner post	N50°E	117.40'
Kent Co. Mon. (G-1, T8N, R11W)	East	338.70'

P.A. 345 1990 KENT COUNTY
PEER APPROVED 3/11/99
CHAIRMAN [signature]

B. Description of corner evidence found and/or method applied in restoring or reestablishing corner:
G-13 Found BROKEN Kent Co. Monument per all of the above witnesses. Removed and reset Kent Co. Monument

SURVEY &
REMONUMENTATION
MAR 08 1999
SECTION

C. Description of monument for corner and accessories established to perpetuate locating the position of the corner:

G-13 Standard Kent County Monument

Nail & KC Remon. tag E. side P. Pole	S00°W	121.13'
Top of South corner of conc. ROW marker	N20°W	97.28'
Top of South corner of conc. ROW marker	N16°E	121.50'
2" Angle Iron Fence Corner Post	N50°E	117.40'
Kent Co. Mon. (G-1, T8N, R11W)	East	338.70'

STATE OF MICHIGAN
KIRK BREITELS
LAND SURVEYOR
NO
30077
LICENSED LAND SURVEYOR

Signed by [signature]
Surveyor's Michigan License No. 30077

Date 12/15/98

FORM APPROVED BY MICHIGAN STATE BOARD OF PROFESSIONAL SURVEYORS, JAN. 28, 1971
REVISED MAY 14,1975
REVISED JAN., 1983
REVISED OCT., 1995