

MAR 08 1999

\$7.00
\$2.00

KENT COUNTY REMONUMENTATION

SECTION

LAND CORNER RECORDATION CERTIFICATE
Filing Requirement of Act 74, Mich. P.A. 1970

For corners in

KENT COUNTY

(County)

Located In:

Corner Code #

- | | | | |
|------------------------------------|--------------|---------------|---------|
| 1. Public Land Survey | T <u>9</u> N | R <u>12</u> W | A-9 |
| | T _____ | R _____ | _____ |
| | T _____ | R _____ | _____ |
| | T _____ | R _____ | _____ |
| 2. Property Controlling in Section | S _____ | T _____ | R _____ |
| | S _____ | T _____ | R _____ |
| 3. Miscellaneous Property in Sec. | S _____ | T _____ | R _____ |
| | S _____ | T _____ | R _____ |

4. Lot No. _____, Recorded Plat _____
5. Private Claims _____

I, Kirk Breitels, in a field survey on Jan. 12, 19 98 do hereby state that under requirements of P.A. 74, Michigan P.A. of 1970, the corner points mentioned in lines 1 and 2 above were in conformance with regulations and rules therefore as required in the current manual of survey instructions of the United States Department of the Interior, Bureau of Land Management or by a decree of a Court of Law and /or that the corner points mentioned in lines 3, 4 and 5 above were in conformance with the rules of the Michigan Board of Land Surveyors or by a Decree of a Court of Law; established, re-established, monumented, recovered, found as expressed below:

NOTE: Not more than 2 corners, all in the same town and range, may be recorded on this certificate.

A. Description of original monument and accessories and/or subsequent restoration:

- | | | | | |
|-----|------|---------------|------------|--|
| A-9 | 1837 | GLO | Brookfield | Set Post |
| | 1963 | Kent Co. Wits | | Boat Spike on Stone |
| | 1976 | LCRC #952 | Bonnema | Solid Iron in Mon. Box |
| | 1982 | LCRC #3195 | Bonnema | Set Kent County Monument in Mon. Box |
| | 1991 | LCRC #6123 | Byl | Reset Kent County Monument in Mon. Box |

P.A. 345 1990 KENT COUNTY
PEER APPROVED 2/19/98
CHAIRMAN [Signature]

The position of this corner was previously approved by the Kent County Remonumentation Peer Group, monumented by Douglas W. Bonnema on 12-8-82 and was recorded per LCRC #3195.

B. Description of corner evidence found and/or method applied in restoring or reestablishing corner:

A-9 Found Kent County Monument (Harrison) per witnesses from above LCRC as set by William R. Byl in the same location as set in 1982 by Douglas W. Bonnema in place of the 1/2" Solid Bar he found inside a Mon. Box. Said Solid Bar checks with Kent Co. Wits. and LCRC #952.

LCRC #3195		LCRC #6123
SE corner garage fnd.	N47°W 53.95'	SE corner garage fnd.
C/L manhole cover	S53°W 28.64'	C/L manhole cover
SE corner house fnd.	N22°E 212.56'	Nail & Remon. tag clump 15" Maples
Nail & Remon. tag cl. 15" Maples	S68°E 125.59'	Nail & Remon. tag P. Pole
NW corner wood house	S18°E 171.71'	Nail & Remon. tag P. Pole
		N10°W 175.96'

The selected location is accepted by me and is generally accepted by professional surveyors as the best available evidence of the position of the original corner.


C. Description of monument for corner and accessories established to perpetuate locating the position of the corner:

- | | |
|---|---------------|
| A-9 Standard Kent County Monument in Mon. Box | |
| SE corner garage foundation | N47°W 53.95' |
| C/L manhole cover | S53°W 28.64' |
| Nail & KC Remon. tag S. side clump 18" Maples | S68°E 126.15' |
| Nail & KC Remon. tag NE side P. Pole | S50°E 40.54' |
| Nail & KC Remon. tag E. side P. Pole | N10°W 176.08' |



Signed by [Signature]
Surveyor's Michigan License No. 30077

Date 2/19/98

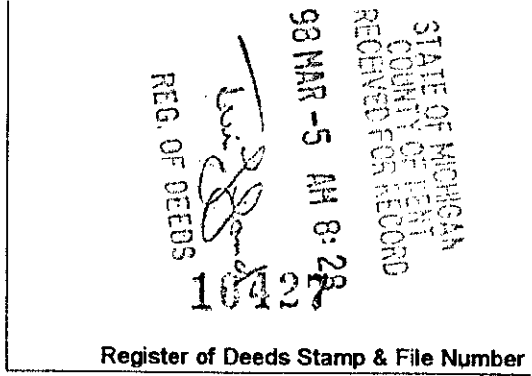

A	B	C	D	E	F	G	H	I	J	K	L	M
1												
2	6		5		4		3		2		1	
3												
4	7		8		9		10		11		12	
5												
6	10		17		16		15		14		13	
7												
8	19		20		21		22		23		24	
9												
10	30		29		28		27		26		25	
11												
12	31		32		33		34		35		36	
13												