

12/28/99

KENT COUNTY REMONUMENTATION

LAND CORNER RECORDATION CERTIFICATE Filing Requirement of Act 74, Mich. P.A. 1970

1999 DEC 30 11:19:20

1999 DEC 30 11:19:20
RECORDS & RECORDS
KENT COUNTY

For corners in

KENT COUNTY
(County)

Located In:

Corner Code #

Sparta Twp.

1. Public Land Survey

T	<u>9</u> NR	<u>12</u> W	<u>B-3</u>
T	___	R	___
T	___	R	___
T	___	R	___
T	___	R	___
S	___	T	___
S	___	T	___
S	___	T	___
S	___	T	___

2. Property Controlling in Section


3. Miscellaneous Property in Sec.

4. Lot No. _____, Recorded Plat _____
5. Private Claims _____

I, Kirk Breitels, in a field survey on Dec. 13, 1999 do hereby state that under requirements of P.A. 74, Michigan P.A. of 1970, the corner points mentioned in lines 1 and 2 above were in conformance with regulations and rules therefore as required in the current manual of survey instructions of the United States Department of the Interior, Bureau of Land Management or by a decree of a Court of Law and /or that the corner points mentioned in lines 3, 4 and 5 above were in conformance with the rules of the Michigan Board of Land Surveyors or by a Decree of a Court of Law; established, re-established, monumented, recovered, found as expressed below:

NOTE: Not more than 2 corners, all in the same town and range, may be recorded on this certificate.

11677
Register of Deeds Stamp & File Number

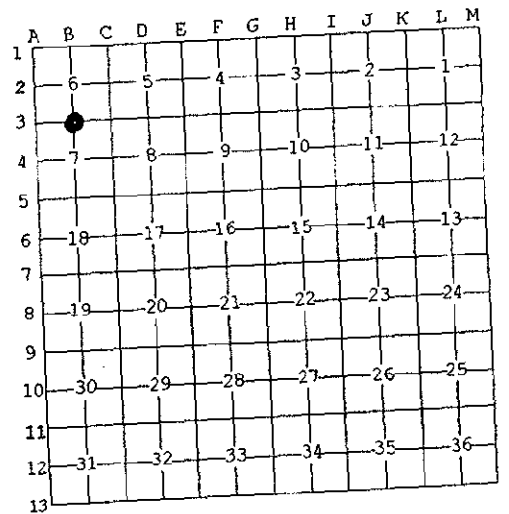

A. Description of original monument and accessories and/or subsequent restoration:

- B-3 Kent County Monument, LCRC #10699
- Nail & KC Remon. tag S. side 22" Oak N75°E 285.22'
- Nail & KC Remon. tag N. side P. Pole S75°E 337.80'
- Nail & KC Remon. tag E. side 16" Maple N18°E 65.49'
- Nail & KC Remon. tag E. side P. Pole S00°E 74.46'
- SE corner conc. retaining wall N68°W 101.27'
- Nail & KC Remon. tag E. side 10" Oak N30°E 104.33'
- In C/L E-W asphalt road ±

P.A. 345 1990 KENT COUNTY.
PEER APPROVED 9/29/98
CHAIRMAN [Signature]

B. Description of corner evidence found and/or method applied in restoring or reestablishing corner:

B-3 Found Kent County Monument
All witnesses above OK


SURVEY &
REMONUMENTATION

MAY 22 2000

SECTION

C. Description of monument for corner and accessories established to perpetuate locating the position of the corner:

- B-3 RESET Standard Kent County Monument in MON. BOX
- Nail & KC Remon. tag S. side 22" Oak N75°E 285.22'
- Nail & KC Remon. tag N. side P. Pole S75°E 337.80'
- Nail & KC Remon. tag E. side 16" Maple N18°E 65.49'
- Nail & KC Remon. tag E. side P. Pole S00°E 74.46'
- SE corner conc. retaining wall N68°W 101.27'
- Nail & KC Remon. tag E. side 10" Oak N30°E 104.33'
- In C/L E-W asphalt road ±

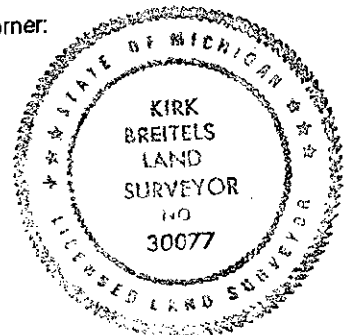

Signed by [Signature]
Surveyor's Michigan License No. 30077

Date 12/28/99