

OCT 28 1994

LAND CORNER RECORDATION CERTIFICATE

Filing Requirement of Act 74, Mich. P.A. 1970

COMMISSION

STATE OF MICHIGAN
COUNTY OF KENT
RECEIVED FOR RECORD

94 AUG 24 AM 11:52

For corners in

Kent
(County)

Located In: Sparta Township
Corner Code #

- | | | |
|------------------------------------|--------------------------|---------------------|
| 1. Public Land Survey | T <u>9N</u> R <u>12W</u> | <u>B-12</u> |
| | T _____ R _____ | <u>cen. sec. 31</u> |
| | T _____ R _____ | _____ |
| | T _____ R _____ | _____ |
| 2. Property Controlling in Section | S _____ T _____ R _____ | _____ |
| | S _____ T _____ R _____ | _____ |
| 3. Miscellaneous Property in Sec. | S _____ T _____ R _____ | _____ |
| | S _____ T _____ R _____ | _____ |

Eric J. Bond
REG. OF DEEDS

6969

Register of Deeds Stamp & File Number

4. Lot No. _____, Recorded Plat _____
5. Private Claims _____

	A	B	C	D	E	F	G	H	I	J	K	L	M
2	6	5	4	3	2	1							
3													
4	7	8	9	10	11	12							
5													
6	18	17	16	15	14	13							
7													
8	19	20	21	22	23	24							
9													
10	30	29	28	27	26	25							
11													
12	▲	32	33	34	35	36							
13													

I, Wallace E. Glaza, in a field survey on August 19, 19 94, do hereby certify that under requirements of P.A. 74, Michigan P.A. of 1970, the corner points mentioned in lines 1 and 2 above were in conformance with regulations and rules therefore as required in the current manual of survey instructions of the United States Department of the Interior, Bureau of Land Management or by a decree of a Court of Law and/or that the corner points mentioned in lines 3, 4 and 5 above were in conformance with the rules of the Michigan Board of Land Surveyors or by a Decree of a Court of Law; established, re-established, monumented, re-monumented, recovered, found as expressed below:

NOTE: Not more than 4 corners, all in the same town and range, may be recorded on this certificate.

A. Description of original monument and accessories and/or subsequent restoration:

No previous history encountered during research

No other information available from the County Surveyor's Office, other surveying firms or any other sources.

B. Description of corner evidence found and/or method applied in restoring or reestablishing corner:

B-12 (Center of Section 31, T9N, R12W, Sparta Township, Kent County, Michigan)

Found capped iron (illegible) in conc. Verified iron to be at the intersection of the 1/4 lines. Accepted iron as center of Section 31. Replaced iron with standard 4" x 30" Kent County Monument (Harrison).


- West 1/4 corner to center - 2558.81'
- North 1/4 corner to center - 2669.18'
- East 1/4 corner to center - 2656.34'
- South 1/4 corner to center - 2653.59'

P.A. 345 1990 KENT COUNTY
PEER APPROVED 7/28/94
CHAIRMAN *Harry Hubert*

C. Description of monument for corner and accessories established to perpetuate locating the position of the corner:

B-12 (4" x 30" Kent County Monument)

- 1) Remon tag & nail in West side of 30" Oak N10°E 294.39'
- 2) Remon tag & nail in East side of 10" Apple S05°E 62.49'
- 3) Remon tag & nail in North side of 12" Apple S60°W 76.51'
- 4) On centerline ± Orchard Lane

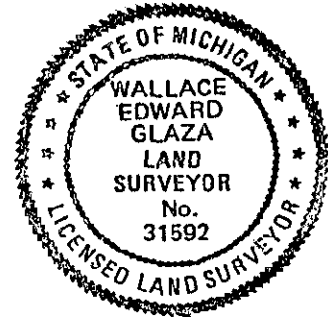

Signed by Wallace E. Glaza
Glaza & Associates, Inc. 31592
Surveyor's Michigan License No. _____

Date 8-22-94