

\$7.00
\$2.00

SEP 18 1995

KENT COUNTY REMONUMENTATION

LAND CORNER RECORDATION CERTIFICATE

Filing Requirement of Act 74, Mich. P.A. 1970

COMMISSION

For corners in
KENT COUNTY
(County)

Located In:

Corner Code #

1. Public Land Survey	T	<u>9N</u>	R	<u>12W</u>	<u>B-13</u>
	T	_____	R	_____	_____
	T	_____	R	_____	_____
	T	_____	R	_____	_____
2. Property Controlling in Section	S	_____	T	_____	_____
	S	_____	T	_____	_____
3. Miscellaneous Property in Section	S	_____	T	_____	_____
	S	_____	T	_____	_____

STATE OF MICHIGAN
COUNTY OF KENT
RECEIVED FOR RECORD

95 JUN 29 PM 12:00


REG. OF DEEDS

Lucy Spauld

8516

Register of Deeds Stamp & File Number

4. Lot No. _____, Recorded Plat _____
5. Private Claims _____

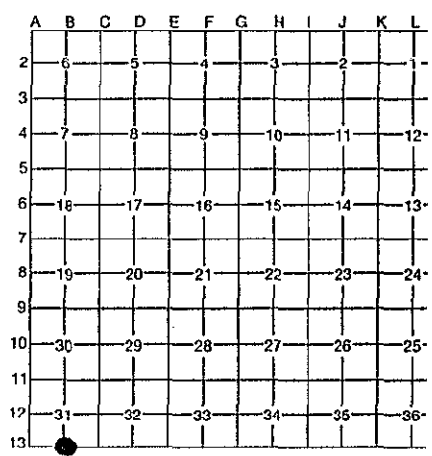

I, Kirk Breitels, in a field survey on March 10, 19 95

do hereby certify that under requirements of P.A. 74, Michigan P.A. of 1970, the corner points mentioned in lines 1 and 2 above were in conformance with regulations and rules therefore as required in the current manual of survey instructions of the United States Department of the Interior, Bureau of Land Management or by a decree of a Court of Law and/or that the corner points mentioned in lines 3, 4 and 5 above were in conformance with the rules of the Michigan Board of Professional Surveyors or by a Decree of a Court of Law; established, re-established, monumented, re-monumented, recovered, found as expressed below:

NOTE: Not more than 4 corners, all in the same town and range, may be recorded on this certificate.

A. Description of original monument and accessories and/or subsequent restoration:

B-13	1837	GLO	Brookfield	Set Post
	1951	Kent Co. Rd. Com.		Conc. Mon.
	1971	Kent Co. Rd. Com.		Mon. Box
	1973	Kent Co. Wit.		Iron in mon. box
	1984	LCRC #4074	Kolehouse	Set Kent County Monument
	1991	LCRC #6132	Byl	Kent County Monument

The position of this corner was previously approved by the Kent County Remonumentation Peer Group, monumented by Randy J. Kolehouse on 11/16/84 and was recorded per LCRC #4074

B. Description of corner evidence found and/or method applied in restoring or reestablishing corner:

B-13 Found standard Kent Co. Mon. (Harrison) per witnesses from above LCRC as set by Randy J. Kolehouse in place of the Iron he found inside a mon. box. Said Iron checks with Kent Co. Wit.

LCRC #4074 & #6132


Nail & KC Remon. tag NE side 24" Oak	S50°E	120.05'
Nail & KC Remon. tag top C/L 8" Wood Post	S55°W	120.70'
Nail & KC Remon. tag W. side P. Pole	N45°E	120.62'
Kent Co. Mon. (B-1, T8N, R12W)	East	307.15'

P.A. 345 1990 KENT COUNTY
PEER APPROVED 6/22/95
CHAIRMAN *Harry Huber*

The selected location is accepted by me and is generally accepted by professional surveyors as the best available evidence of the position of the original corner.

C. Description of monument for corner and accessories established to perpetuate locating the position of the corner:

B-13 Standard Kent County Monument in mon. box		
Nail & KC Remon. tag NE side 26" Oak	S50°E	120.05'
Nail & KC Remon. tag top C/L 8" Wood Post	S55°W	120.70'
Nail & KC Remon. tag W. side P. Pole	N45°E	120.62'
Kent Co. Mon. (B-1, T8N, R12W)	East	307.10'

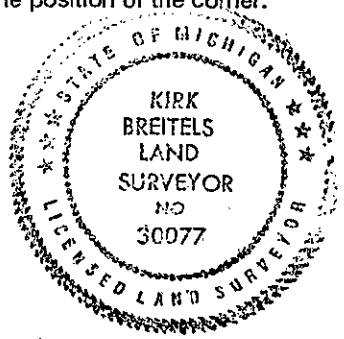

Signed by *Kirk Breitels*

Date 6/22/95

Surveyor's Michigan License No. 30077