

SURVEY & REMONUMENTATION

MAR 08 1999

KENT COUNTY REMONUMENTATION

LAND CORNER RECORDATION CERTIFICATE
Filing Requirement of Act 74, Mich. P.A. 1970

\$7.00
\$2.00

SECTION

STATE OF MICHIGAN
COUNTY OF KENT
RECEIVED FOR RECORD
98 MAR -5 AM 8:28
REG. OF DEEDS
David J. ...

For corners in

KENT COUNTY
(County)

Located In:

Corner Code #

- | | | |
|------------------------------------|--|------------|
| 1. Public Land Survey | T <u>0N</u> R <u>12W</u> | <u>C-4</u> |
| | T <u> </u> R <u> </u> | <u> </u> |
| | T <u> </u> R <u> </u> | <u> </u> |
| | T <u> </u> R <u> </u> | <u> </u> |
| 2. Property Controlling in Section | S <u> </u> T <u> </u> R <u> </u> | <u> </u> |
| | S <u> </u> T <u> </u> R <u> </u> | <u> </u> |
| 3. Miscellaneous Property in Sec. | S <u> </u> T <u> </u> R <u> </u> | <u> </u> |
| | S <u> </u> T <u> </u> R <u> </u> | <u> </u> |


10435

Register of Deeds Stamp & File Number

4. Lot No. _____, Recorded Plat _____
5. Private Claims _____

I, Kirk Breitels, in a field survey on Jan. 20, 1998 do hereby state that under requirements of P.A. 74, Michigan P.A. of 1970, the corner points mentioned in lines 1 and 2 above were in conformance with regulations and rules therefore as required in the current manual of survey instructions of the United States Department of the Interior, Bureau of Land Management or by a decree of a Court of Law and for that the corner points mentioned in lines 3, 4 and 5 above were in conformance with the rules of the Michigan Board of Land Surveyors or by a Decree of a Court of Law; established, re-established, monumented, recovered, found as expressed below:

NOTE: Not more than 2 corners, all in the same town and range, may be recorded on this certificate.

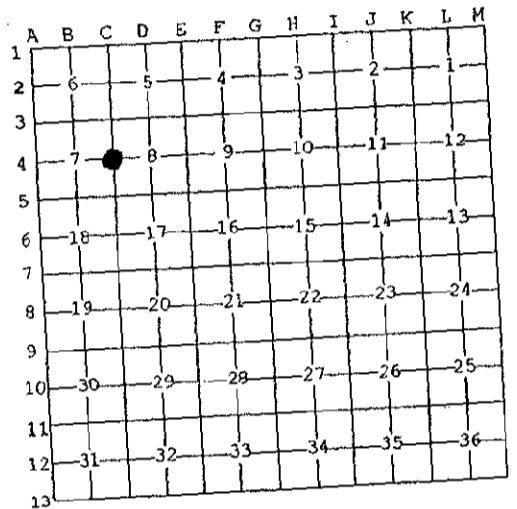

A. Description of original monument and accessories and/or subsequent restoration:

- | | | | | |
|-----|------|---------------|------------|--|
| C-4 | 1837 | GLO | Whitcomb | Set Post |
| | 1963 | Kent Co. Wits | | 1" Iron |
| | 1980 | LCRC #1339 | Merdzinski | 5/8" Iron in Mon. Box |
| | 1982 | LCRC #2951 | Merdzinski | Set Kent County Monument in Mon. Box |
| | 1991 | LCRC #6135 | Byl | Reset Kent County Monument in Mon. Box |

P.A. 345 1990 KENT COUNTY
PEER APPROVED 2/19/98
CHAIRMAN Harry ...

The position of this corner was previously approved by the Kent County Remonumentation Peer Group, monumented by John A. Merdzinski on 6-28-82 and was recorded per LCRC #2951.

B. Description of corner evidence found and/or method applied in restoring or reestablishing corner:

- C-4 Found Kent County Monument (Harrison) per witnesses from above LCRC as set by in a Mon. Box by William R. Byl at the same location as set in 1982 by John A. Merdzinski in place of the 5/8" Iron over a 1" Iron he found inside a Mon. Box. Both Irons check with LCRC #1339. Kent Co. Wits. all gone.
LCRC #2951
SW cor. brick planter N30°W 109.80' Nail & Remon. tag P. Pole S20°W 182.61'
Nail & Remon. tag P. Pole S20°W 182.70' C/L manhole N45°W 39.18' SE cor. brk. sign N30°W 116.85'
C/L manhole N45°W 39.20' C/L MBT Box S35°E 37.42' E. cor. R/W mon. N70°W 126.61'
Nail & Remon. tag in curb joint S50°W 45.00' S'ly cor. R/W mon. N20°W 118.35'
Nail & Remon. tag 12" Apple S40°E 71.91' PK Nail & Remon. tag curb joint S50°W 43.60'

C. Description of monument for corner and accessories established to perpetuate locating the position of the corner:

- C-4 Standard Kent County Monument in Mon. Box
Nail & KC Remon. tag E. side P. Pole S20°W 182.65'
C/L manhole N45°W 39.18'
SE cor. brick sign foundation N30°W 116.90'
S'ly corner R/W monument N20°W 118.40'
E'ly corner R/W monument N70°W 126.70'
PK Nail & KC Remon. tag in curb joint S50°W 43.65'
C/L top Tele. Box S35°E 37.42'



Signed by Kirk Breitels
Surveyor's Michigan License No. 30077

Date 2/19/98