

**SURVEY & REMONUMENTATION**

MAR 08 1999

\$7.00  
\$2.00

SECTION

**KENT COUNTY REMONUMENTATION**

**LAND CORNER RECORDATION CERTIFICATE**  
Filing Requirement of Act 74, Mich. P.A. 1970

STATE OF MICHIGAN  
COUNTY OF KENT  
RECEIVED FOR RECORD  
98 MAR -5 AM 8:28  
REG. OF DEEDS  
*Barbara*

For corners in

KENT COUNTY Located in: \_\_\_\_\_ Corner Code # \_\_\_\_\_  
(County)

1. Public Land Survey T 9N R 12W C-6  
T \_\_\_\_\_ R \_\_\_\_\_  
T \_\_\_\_\_ R \_\_\_\_\_  
T \_\_\_\_\_ R \_\_\_\_\_

2. Property Controlling S \_\_\_\_\_ T \_\_\_\_\_ R \_\_\_\_\_  
in Section S \_\_\_\_\_ T \_\_\_\_\_ R \_\_\_\_\_

3. Miscellaneous S \_\_\_\_\_ T \_\_\_\_\_ R \_\_\_\_\_  
Property in Sec. S \_\_\_\_\_ T \_\_\_\_\_ R \_\_\_\_\_


4. Lot No. \_\_\_\_\_, Recorded Plat \_\_\_\_\_

5. Private Claims \_\_\_\_\_

10437

Register of Deeds Stamp & File Number

I, Kirk Breitels, in a field survey on Jan. 13, 19 98 do hereby state that under requirements of P.A. 74, Michigan P.A. of 1970, the corner points mentioned in lines 1 and 2 above were in conformance with regulations and rules therefore as required in the current manual of survey instructions of the United States Department of the Interior, Bureau of Land Management or by a decree of a Court of Law and/or that the corner points mentioned in lines 3, 4 and 5 above were in conformance with the rules of the Michigan Board of Land Surveyors or by a Decree of a Court of Law, established, re-established, monumented, recovered, found as expressed below:

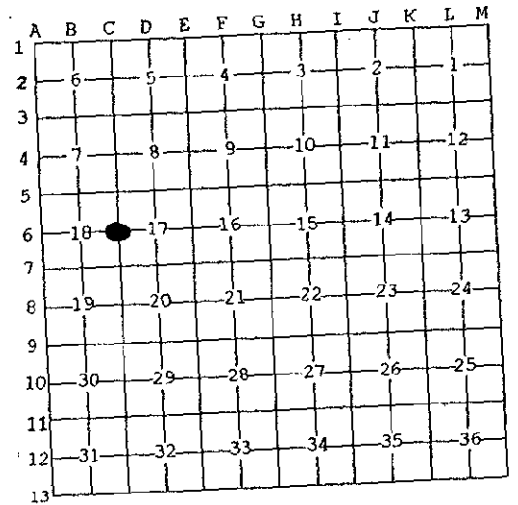

NOTE: Not more than 2 corners, all in the same town and range, may be recorded on this certificate.

A. Description of original monument and accessories and/or subsequent restoration:

C-6	1837	GLO	Whitcomb	Set Post
	1963	Kent Co. Wits		1" Iron
	1979	LCRC #1257	Bonnema	1" Iron in Mon. Box
	1982	LCRC #2621	Nederveld	Set Kent County Monument in Mon. Box
	1991	LCRC #6137	Byl	Reset Kent County Monument in Mon. Box

P.A. 345 1990 KENT COUNTY  
PEER APPROVED 2/19/98  
CHAIRMAN Harry Fisher

The position of this corner was previously approved by the Kent County Remonumentation Peer Group, monumented by Gordon D. Nederveld on 1-25-82 and was recorded per LCRC #2621.

B. Description of corner evidence found and/or method applied in restoring or reestablishing corner:

C-6 Found Kent County Monument (Harrison) per witnesses from above LCRC as set by William R. Byl at the same location as set in 1982 by Gordon D. Nederveld in place of the 1" Iron he found inside a Mon. Box. Said Iron checks with Kent Co. Wits. and LCRC #1257.

LCRC #2621	Nail & Remon. tag 18" Maple S45°E 46.82'	LCRC #6137	Nail & Remon. tag 24" Maple S45°W 46.82'
	Nail & Remon. tag 20" Pine S18°E 46.85'		Nail & Remon. tag 24" Pine S18°E 46.80'
	Nail & Remon. tag 20" Maple N68°E 35.44'		Nail & Remon. tag 24" Maple N68°E 35.44'
	Nail & Remon. tag 26" Maple N42°W 57.77'		Nail & Remon. tag 30" Maple N42°W 57.77'
			C/L Fruit Ridge Ave. is West 3' ±

The selected location is accepted by me and is generally accepted by professional surveyors as the best available evidence of the position of the original corner.

C. Description of monument for corner and accessories established to perpetuate locating the position of the corner:

C-6 Standard Kent County Monument in Mon. Box

Nail & KC Remon. tag SE side 27" Maple	S45°W 46.82'
Large Spike NE side 30" Maple	N42°W 57.81'
Nail & KC Remon. tag E. side 24" Maple	S15°W 85.05'
Nail & KC Remon. tag E. side 24" Maple	N15°W 89.42'
C/L 1" Apple Tree	S80°E 56.4'
C/L 1" Apple Tree	S30°E 61.7'



Signed by Kirk Breitels  
Surveyor's Michigan License No. 30077

Date 2/19/98