SURVEY & REMONUMENTATION

MAR 08 1999

$7.00
$2.00

SECTION

KENT COUNTY REMONUMENTATION

LAND CORNER RECORDATION CERTIFICATE
Filing Requirement of Act 74, Mich. P.A. 1970

STATE OF MICHIGAN COUNTY OF KENT RECEIVED FOR RECORD 98 MAR -5 AM 8:28

REG. OF DEEDS

For corners in

KENT COUNTY (County) Located In: Corner Code #

1. Public Land Survey		T 9N	R 12W	D-7
		T___	R___	
		T___	R___	
		T___	R___	
2. Property Controlling in Section	S___	T___	R___	
	S___	T___	R___	
3. Miscellaneous Property in Sec.	S___	T___	R___	
	S___	T___	R___	

10444
Register of Deeds Stamp & File Number

4. Lot No. _____ , Recorded Plat _____
5. Private Claims _____

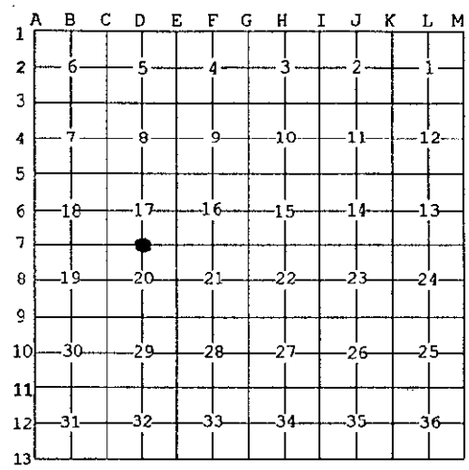

I, Kirk Breitels, in a field survey on Jan. 26, 19 98 do hereby state that under requirements of P.A. 74, Michigan P.A. of 1970, the corner points mentioned in lines 1 and 2 above were in conformance with regulations and rules therefore as required in the current manual of survey instructions of the United States Department of the Interior, Bureau of Land Management or by a decree of a Court of Law and /or that the corner points mentioned in lines 3, 4 and 5 above were in conformance with the rules of the Michigan Board of Land Surveyors or by a Decree of a Court of Law; established, re-established, monumented, recovered, found as expressed below:

NOTE: Not more than 2 corners, all in the same town and range, may be recorded on this certificate.

A. Description of original monument and accessories and/or subsequent restoration:

D-7	1837	GLO	Whitcomb	Set Post
		Kent Co. Wits		Iron on Stone
	1972	LCRC #209	Bonnema	2 ½" Iron in Mon. Box
	1979	LCRC #1254	Merdzinski	Iron in Mon. Box
	1982	LCRC #2620	Nederveld	Set Kent County Monument in Mon. Box
	1991	LCRC #6147	Byl	Kent County Monument in Mon. Box

P.A. 345 1990 KENT COUNTY
PEER APPROVED 2/19/98
CHAIRMAN Harry Huber

The position of this corner was previously approved by the Kent County Remonumentation Peer Group, monumented by Gordon D. Nederveld on 1-25-82 and was recorded per LCRC #2620.

B. Description of corner evidence found and/or method applied in restoring or reestablishing corner:

D-7 Found Kent County Monument (Harrison) per witnesses from above LCRC as set by Gordon D. Nederveld in place of the 2" Round Iron he found inside a Mon. Box. Said Iron checks with Kent Co. Wits. and LCRC's #209 & #1254.

LCRC #2620			LCRC #6147		
Nail & Remon. tag P. Pole	S00°W	58.06'	Nail & Remon. tag P. Pole	S00°W	58.04'
Nail & Remon. tag T. Pole	N60°W	78.05'	Steel Bar (Glaza)	N00°E	33.03'
Nail & Remon. tag T. Pole	N72°E	102.23'	Nail & Remon. tag	S60°E	49.09'
NE cor. conc. headwall	N30°E	40.85'	Nail & Remon. tag	S30°E	34.62'

The selected location is accepted by me and is generally accepted by professional surveyors as the best available evidence of the position of the original corner.

C. Description of monument for corner and accessories established to perpetuate locating the position of the corner:

D-7 Standard Kent County Monument in Mon. Box

Nail & KC Remon. tag E. side P. Pole	S00°W	57.96'
Steel Bar (Glaza)	N00°E	33.03'
Nail & KC Remon. tag W. side 8" Cherry	S30°E	34.57'
Nail & KC Remon. tag N. side 10" Elm	S60°E	58.50'
Nail & KC Remon. tag SW side 12" Ash	N20°W	51.97'

STATE OF MICHIGAN
KIRK BREITELS
LAND SURVEYOR
NO 30077
LICENSED LAND SURVEYOR

Signed by Kirk Breitels Date 2/19/98

Surveyor's Michigan License No. 30077

FORM APPROVED BY MICHIGAN STATE BOARD OF PROFESSIONAL SURVEYORS, JAN. 28, 1971
REVISED MAY 14, 1975
REVISED JAN., 1983
REVISED OCT., 1995