SURVEY & REMONUMENTATION

MAR 08 1999

SECTION

KENT COUNTY REMONUMENTATION

**LAND CORNER RECORDATION CERTIFICATE**
**Filing Requirement of Act 74, Mich. P.A. 1970**

STATE OF MICHIGAN
COUNTY OF KENT
RECEIVED FOR RECORD
98 OCT -7 AM 10: 15
REG. OF DEEDS

10709
Register of Deeds Stamp & File Number

For corners in
KENT COUNTY
(County)

| | Located In: | | Corner Code # |
|---|---|---|---|
| 1. Public Land Survey | | T 9N R 12W | D-8 |
| | | T___ R___ | |
| | | T___ R___ | |
| | | T___ R___ | |
| 2. Property Controlling in Section | S___ | T___ R___ | |
| | S___ | T___ R___ | |
| 3. Miscellaneous Property in Sec. | S___ | T___ R___ | |
| | S___ | T___ R___ | |

4. Lot No. _____ , Recorded Plat _____
5. Private Claims _____

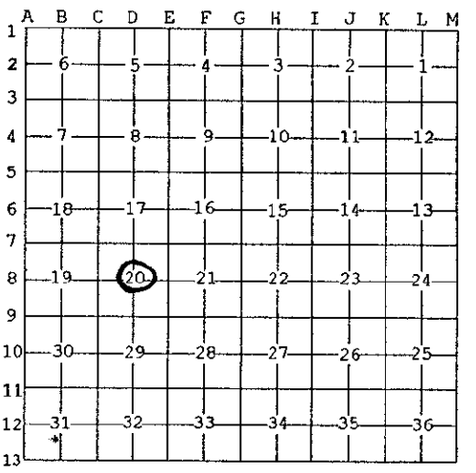


I, Kirk Breitels, in a field survey on Aug. 17, 19 98 do hereby state that under requirements of P.A. 74, Michigan P.A. of 1970, the corner points mentioned in lines 1 and 2 above were in conformance with regulations and rules therefore as required in the current manual of survey instructions of the United States Department of the Interior, Bureau of Land Management or by a decree of a Court of Law and /or that the corner points mentioned in lines 3, 4 and 5 above were in conformance with the rules of the Michigan Board of Land Surveyors or by a Decree of a Court of Law; established, re-established, monumented, recovered, found as expressed below:

NOTE: Not more than 2 corners, all in the same town and range, may be recorded on this certificate.

A. Description of original monument and accessories and/or subsequent restoration:

| | | | |
|---|---|---|---|
| D-8 | 1837 | GLO | Not Set |
| | | Williams & Works | No information |
| | | Kent Co. Wits | No information |

P.A. 345 1990 KENT COUNTY
PEER APPROVED 8/20/98
CHAIRMAN [signature]

B. Description of corner evidence found and/or method applied in restoring or reestablishing corner:

D-8 Established Intersection of 1/4 lines. Location is at East edge of "open space" between orchard and woods. No real occupation nearby (new wire electric fence is East 5').

The Intersection of 1/4 lines is accepted by me and is generally accepted by professional surveyors as the best available evidence of the position of the corner.

C. Description of monument for corner and accessories established to perpetuate locating the position of the corner:

D-8 Set Standard Kent County Monument at the Intersection of 1/4 lines.

| | | |
|---|---|---|
| Nail & KC Remon. tag E. side 8" Apple | S10°E | 41.61' |
| Nail & KC Remon. tag N. side 12" Basswood | S70°E | 24.97' |
| Nail & KC Remon. tag NW side 15" Ash | N50°E | 27.27' |
| Nail & KC Remon. tag W. side 10" Hickory | N10°E | 24.07' |
| Nail & KC Remon. tag N. side 16" Elm | N70°W | 177.60' |

STATE OF MICHIGAN
KIRK BREITELS
LAND SURVEYOR
NO
30077
LICENSED LAND SURVEYOR

Signed by [signature]
Surveyor's Michigan License No. 30077

Date 9/25/98

FORM APPROVED BY MICHIGAN STATE BOARD OF PROFESSIONAL SURVEYORS, JAN. 28, 1971
REVISED MAY 14,1975
REVISED JAN., 1983
REVISED OCT., 1995