SURVEY & REMONUMENTATION

$7.00
$2.00

MAR 0 8 1999

SECTION

KENT COUNTY REMONUMENTATION

LAND CORNER RECORDATION CERTIFICATE
Filing Requirement of Act 74, Mich. P.A. 1970

STATE OF MICHIGAN
COUNTY OF KENT
RECEIVED FOR RECORD
98 MAR -5 AM 8:28
REG. OF DEEDS

10446
Register of Deeds Stamp & File Number

For corners in

KENT COUNTY
(County)

	Located In:		Corner Code #
1. Public Land Survey		T 9N R 12W	E-1
		T___ R___	
		T___ R___	
		T___ R___	
2. Property Controlling	S___	T___ R___	
in Section	S___	T___ R___	
3. Miscellaneous	S___	T___ R___	
Property in Sec.	S___	T___ R___	

4. Lot No. _____, Recorded Plat _____
5. Private Claims _____

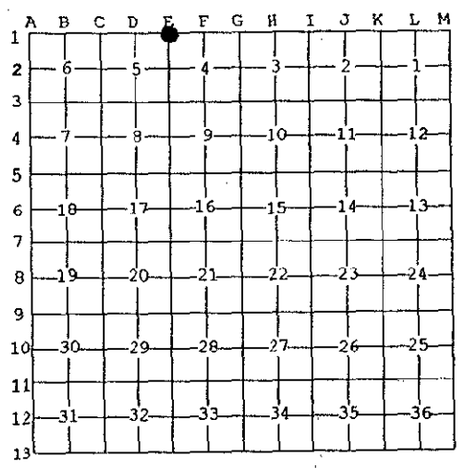

I, Kirk Breitels, in a field survey on Jan. 26, 19 98 do hereby state that under requirements of P.A. 74, Michigan P.A. of 1970, the corner points mentioned in lines 1 and 2 above were in conformance with regulations and rules therefore as required in the current manual of survey instructions of the United States Department of the Interior, Bureau of Land Management or by a decree of a Court of Law and /or that the corner points mentioned in lines 3, 4 and 5 above were in conformance with the rules of the Michigan Board of Land Surveyors or by a Decree of a Court of Law; established, re-established, monumented, recovered, found as expressed below:

NOTE: Not more than 2 corners, all in the same town and range, may be recorded on this certificate.

A. Description of original monument and accessories and/or subsequent restoration:

E-1	1837	GLO	Whitcomb	Set Post 48 links (31.68') East of E-13, T10N, R12W
	1935	Kent Co. Wits		1" Iron on Stone
	1980	LCRC #1383	Jonker	1" Round Iron
	1992	LCRC #6603	Bueche	Set Kent County Monument
	1994	LCRC #7564	J. Glaza	Kent County Monument

P.A. 345 1990 KENT COUNTY
PEER APPROVED 2/19/98
CHAIRMAN

The position of this corner was previously approved by the Kent County Remonumentation Peer Group, monumented by John C. Bueche on 10-12-92 and was recorded per LCRC #6603.

B. Description of corner evidence found and/or method applied in restoring or reestablishing corner:

E-1 Found Kent County Monument (Harrison) per witnesses from above LCRC as set by John C. Bueche in place of the RR Spike he found. Said RR Spike checks with Kent Co. Wits. and LCRC #1383.

LCRC #6603			LCRC #7564		
Nail & Remon. tag P. Pole	N70°E	87.44'	Nail & Remon. tag P. Pole	N70°E	87.44'
Nail & Remon. tag P. Pole	S40°E	26.35'	Nail & Remon. tag P. Pole	S40°E	26.35'
Nail & Remon. tag P. Pole	S25°W	68.01'	Nail & Remon. tag P. Pole	S25°W	68.01'
Nail & Remon. tag 10" Basswood	N40°W	54.57'	Nail & Remon. tag 12" Basswood	N40°W	54.57'
Kent Co. Mon. (E-13, T10N, R12W)	West	31.77'	Kent Co. Mon. (E-13, T10N, R12W)	West	31.77'
C/L of bit. N-S is West 12' ±			C/L bit. N-S is West 12' ±		

The selected location is accepted by me and is generally accepted by professional surveyors as the best available evidence of the position of the original corner.

C. Description of monument for corner and accessories established to perpetuate locating the position of the corner:

E-1 Standard Kent County Monument

Nail & KC Remon. tag N. side P. Pole	N70°E	87.41'
Nail & KC Remon. tag NE side P. Pole	S40°E	26.39'
Nail & KC Remon. tag NE side Tw. 6" Basswood	N40°W	54.34'
Nail & KC Remon. tag E. side 14" Basswood	S25°W	76.93'
Kent Co. Mon. (E-13, T10N, R12W)	West	31.77'
C/L bit. N-S is West 12' ±		

STATE OF MICHIGAN
KIRK BREITELS
LAND SURVEYOR
NO 30077
LICENSED LAND SURVEYOR

Signed by _____ Date 2/19/98

Surveyor's Michigan License No. 30077

FORM APPROVED BY MICHIGAN STATE BOARD OF PROFESSIONAL SURVEYORS, JAN. 28, 1971
REVISED MAY 14, 1975
REVISED JAN., 1983
REVISED OCT., 1995