

**SURVEY & REMONUMENTATION**

MAR 08 1999

**KENT COUNTY REMONUMENTATION**

**SECTION LAND CORNER RECORDATION CERTIFICATE**  
**Filing Requirement of Act 74, Mich. P.A. 1970**

For corners in

KENT COUNTY  
 (County)

Located in: Corner Code #


- 1. Public Land Survey T 9N R 12W E-6  
T \_\_\_\_\_ R \_\_\_\_\_  
T \_\_\_\_\_ R \_\_\_\_\_  
T \_\_\_\_\_ R \_\_\_\_\_
- 2. Property Controlling in Section S \_\_\_\_\_ T \_\_\_\_\_ R \_\_\_\_\_  
S \_\_\_\_\_ T \_\_\_\_\_ R \_\_\_\_\_
- 3. Miscellaneous Property in Sec. S \_\_\_\_\_ T \_\_\_\_\_ R \_\_\_\_\_  
S \_\_\_\_\_ T \_\_\_\_\_ R \_\_\_\_\_
- 4. Lot No. \_\_\_\_\_, Recorded Plat \_\_\_\_\_
- 5. Private Claims \_\_\_\_\_

REG. OF DEEDS  
 STATE OF MICHIGAN  
 COUNTY OF KENT  
 RECEIVED FOR RECORD  
 98 MAR -5 AM 8:29  
*David Standa*

**10450**  
 Register of Deeds Stamp & File Number

I, Kirk Breitels, in a field survey on Jan. 12, 19 98 do hereby state that under requirements of P.A. 74, Michigan P.A. of 1970, the corner points mentioned in lines 1 and 2 above were in conformance with regulations and rules therefore as required in the current manual of survey instructions of the United States Department of the Interior, Bureau of Land Management or by a decree of a Court of Law and /or that the corner points mentioned in lines 3, 4 and 5 above were in conformance with the rules of the Michigan Board of Land Surveyors or by a Decree of a Court of Law; established, re-established, monumented, recovered, found as expressed below:

NOTE: Not more than 2 corners, all in the same town and range, may be recorded on this certificate.

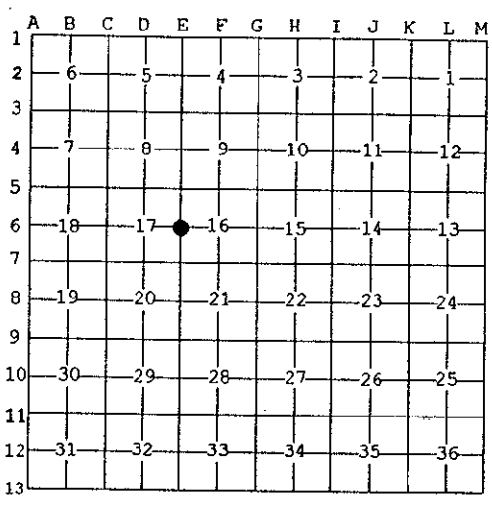

- A. Description of original monument and accessories and/or subsequent restoration:
- |     |      |               |           |                                      |
|-----|------|---------------|-----------|--------------------------------------|
| E-6 | 1837 | GLO           | Whitcomb  | Set Post                             |
|     | 1944 | Kent Co. Wits |           | 2" Pipe                              |
|     | 1979 | LCRC #1311    | Nederveld | 2" Iron in Mon. Box                  |
|     | 1983 | LCRC #3379    | Stadt     | Set Kent County Monument in Mon. Box |
|     | 1991 | LCRC #6155    | Byl       | Kent County Monument in Mon. Box     |

P.A. 345 1990 KENT COUNTY  
 PEER APPROVED 2/19/98  
 CHAIRMAN *Handwritten Signature*

The position of this corner was previously approved by the Kent County Remonumentation Peer Group, monumented by Russell E. Stadt on 5-16-83 and was recorded per LCRC #3379.

- B. Description of corner evidence found and/or method applied in restoring or reestablishing corner:
- E-6 Found Kent County Monument (Harrison) per witnesses from above LCRC as set by Russell E. Stadt in place of the Iron he found inside a Mon. Box. Said Iron checks with Kent Co. Wits. and LCRC #1311.
- |   |              |                                |              |
|---|--------------|--------------------------------|--------------|
| LCRC #3379                              |              | LCRC #6155                     |              |
| Nail & Remon. tag 14" Oak               | S65°W 35.22' | Nail & Remon. tag 18" Oak      | S65°W 35.40' |
| Nail & Remon. tag 20" Oak               | S35°W 64.05' | Nail & Remon. tag 27" Oak      | S35°W 64.17' |
| Nail & Remon. tag Tri. 10" Poplar       | N40°E 52.12' | Nail & Remon. tag 16" Basswood | S90°W 94.50' |
| Nail & Remon. tag Tri. 10" Elm          | N20°E 76.65' | Nail & Remon. tag 12" Poplar   | N25°E 72.06' |
| Nail & Remon. tag top C/L fc. post West | 42.22'       | Nail & Remon. tag 10" Poplar   | N45°E 34.82' |
- C/L road N-S is 1.5' East ±

The selected location is accepted by me and is generally accepted by professional surveyors as the best available evidence of the position of the original corner.

C. Description of monument for corner and accessories established to perpetuate locating the position of the corner:

- E-6 Standard Kent County Monument in Mon. Box
- |   |              |
|---|--------------|
| Nail & KC Remon. tag SE side 22" Oak      | S65°W 35.40' |
| Nail & KC Remon. tag SE side 30" Oak      | S35°W 63.09' |
| Nail & KC Remon. tag N. side 20" Basswood | S90°W 94.32' |
| Nail & KC Remon. tag W. side 14" Poplar   | N25°E 72.02' |
| Nail & KC Remon. tag SE side 12" Poplar   | N45°E 34.77' |



Signed by *Kirk Breitels*  
 Surveyor's Michigan License No. 30077

Date 2/19/98