

MAR 08 1999

KENT COUNTY REMONUMENTATION

\$7.00
\$2.00

SECTION

LAND CORNER RECORDATION CERTIFICATE
Filing Requirement of Act 74, Mich. P.A. 1970

For corners in
KENT COUNTY
(County)

Located In:	Corner Code #
T 9N R 12W	E-9
T R	
T R	
T R	
S T R	
S T R	
S T R	
S T R	

1. Public Land Survey

2. Property Controlling in Section


3. Miscellaneous Property in Sec.

4. Lot No. _____, Recorded Plat _____
5. Private Claims _____

STATE OF MICHIGAN
COUNTY OF KENT
RECEIVED FOR RECORDS
98 MAY 21 AM 8:32
REG. OF DEEDS
Handwritten signature

10620

Register of Deeds Stamp & File Number

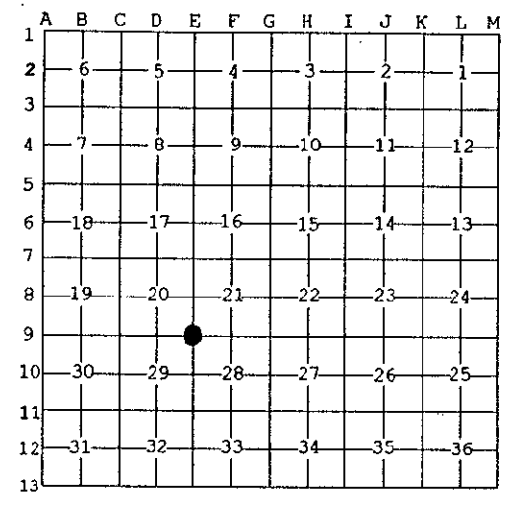

I, Kirk Breitels, in a field survey on April 28, 1998 do hereby state that under requirements of P.A. 74, Michigan P.A. of 1970, the corner points mentioned in lines 1 and 2 above were in conformance with regulations and rules therefore as required in the current manual of survey instructions of the United States Department of the Interior, Bureau of Land Management or by a decree of a Court of Law and for that the corner points mentioned in lines 3, 4 and 5 above were in conformance with the rules of the Michigan Board of Land Surveyors or by a Decree of a Court of Law; established, re-established, monumented, recovered, found as expressed below:

NOTE: Not more than 2 corners, all in the same town and range, may be recorded on this certificate.

A. Description of original monument and accessories and/or subsequent restoration:

E-9	1837	GLO	Whitcomb	Set Post
	1949	Kent Co. Wits		Iron
	1979	LCRC #1253	Merdzinski	Iron
	1982	LCRC #2619	Nederveld	Set Kent County Monument
	1991	LCRC #6158	Byl	Kent County Monument

P.A. 345 1990 KENT COUNTY
PEER APPROVED 4/30/98
CHAIRMAN *Handwritten signature*

The position of this corner was previously approved by the Kent County Remonumentation Peer Group, monumented by Gordon D. Nederveld on 1-25-82 and was recorded per LCRC #2619.

B. Description of corner evidence found and/or method applied in restoring or reestablishing corner:

LCRC #2619	LCRC #6158
Nail & Remon. tag P. Pole	N65°E 75.95' Nail & Remon. tag P. Pole N85°E 76.15'
Nail & Remon. tag 26" Basswood	N82°E 92.06' Nail & Remon. tag 30" Basswood N82°E 92.06'
Nail & Remon. tag P. Pole	S48°E 86.68' Nail & Remon. tag P. Pole N32°W 47.06'
Nail & Remon. tag P. Pole	N32°W 46.98' Nail & Remon. tag 10" Elm N20°W 72.61'
	C/L 12 Mile Rd. is South 2'
	C/L Peach Ridge Ave. is East 4'

The selected location is accepted by me and is generally accepted by professional surveyors as the best available evidence of the position of the original corner.

C. Description of monument for corner and accessories established to perpetuate locating the position of the corner:

E-9 Standard Kent County Monument	
Nail & KC Remon. tag S. side 36" Basswood	N82°E 92.08'
NW corner Tele. pedestal	S45°E 61.39'
NW corner stop sign post	S75°W 58.81'
Nail & KC Remon. tag W. side 18" Walnut	N20°E 114.28'
Nail & KC Remon. tag NW side P. Pole	N65°E 78.08'
C/L 12 Mile Rd. is 2' South	
C/L Peach Ridge Ave. is 4' East	



Signed by *Handwritten signature*
Surveyor's Michigan License No. 30077

Date 4/30/98