

MAR 08 1999

KENT COUNTY REMONUMENTATION

SECTION

LAND CORNER RECORDATION CERTIFICATE
Filing Requirement of Act 74, Mich. P.A. 1970

\$7.00
\$2.00

For corners in

KENT COUNTY
(County)

Located In:

Corner Code #

1. Public Land Survey	T <u>9</u> N R <u>12</u> W	E-11
	T ___ R ___	_____
	T ___ R ___	_____
	T ___ R ___	_____
2. Property Controlling in Section	S ___ T ___ R ___	_____
	S ___ T ___ R ___	_____
3. Miscellaneous Property in Sec.	S ___ T ___ R ___	_____
	S ___ T ___ R ___	_____

STATE OF MICHIGAN
COUNTY OF KENT
RECEIVED FOR RECORDS
98 MAY 21 AM 8:32
REG. OF DEEDS
Lucy Stand


10621

Register of Deeds Stamp & File Number

4. Lot No. _____, Recorded Plat _____
5. Private Claims _____

I, Kirk Breitels, in a field survey on April 7, 19 98 do hereby state that under requirements of P.A. 74, Michigan P.A. of 1970, the corner points mentioned in lines 1 and 2 above were in conformance with regulations and rules therefore as required in the current manual of survey instructions of the United States Department of the Interior, Bureau of Land Management or by a decree of a Court of Law and /or that the corner points mentioned in lines 3, 4 and 5 above were in conformance with the rules of the Michigan Board of Land Surveyors or by a Decree of a Court of Law; established, re-established, monumented, recovered, found as expressed below:

NOTE: Not more than 2 corners, all in the same town and range, may be recorded on this certificate.

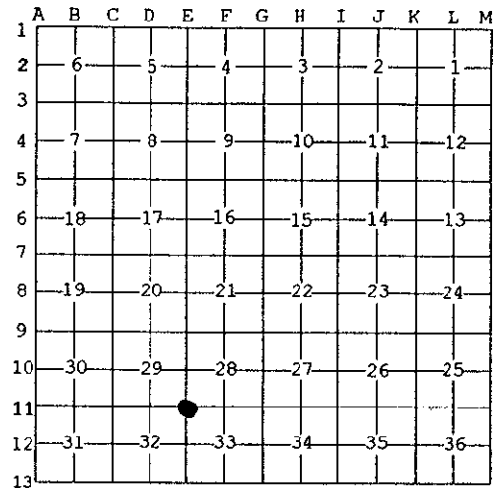

A. Description of original monument and accessories and/or subsequent restoration:

E-11	1837	GLO	Whitcomb	Set Post
	1935	Kent Co. Wits		"X" on flat stone
	1978	LCRC #3256	Hay	Iron in Mon. Box
	1983	LCRC #3459	Stadt	Set Kent County Monument in Mon. Box
	1991	LCRC #6160	Byl	Kent County Monument in Mon. Box

P.A. 345 1990 KENT COUNTY

PEER APPROVED 4/30/98
CHAIRMAN [Signature]

The position of this corner was previously approved by the Kent County Remonumentation Peer Group, monumented by Russell E. Stadt on 7-26-83 and was recorded per LCRC#3459.

B. Description of corner evidence found and/or method applied in restoring or reestablishing corner:

E-11 Found Kent County Monument (Harrison) per witnesses from above LCRC as set by Russell E. Stadt in place of the 3/4" Iron he found inside a Mon. Box. Said Iron checks with LCRC #3256. Kent Co. Wit. all gone.

LCRC #3459	C/L square cut top conc. culv. N10°W 86.40'	C/L square cut top conc. culv. N10°W 86.40'
	C/L "X" cut top conc. culv. N10°E 84.66'	C/L square cut top conc. culv. N10°E 84.57'
	Nail & Remon. tag 20" Apple N45°E 86.73'	Nail & Remon. tag 20" Apple N45°E 86.73'
	Nail & Remon. tag CP Pole S45°E 68.98'	Nail & Remon. tag CP Pole S45°E 68.98'
	Nail & Remon. tag CP Pole S45°W 64.60'	Nail & Remon. tag CP Pole S45°W 64.62'

On C/L Peach Ridge Ave. & 11 Mile Rd.

The selected location is accepted by me and is generally accepted by professional surveyors as the best available evidence of the position of the original corner.

C. Description of monument for corner and accessories established to perpetuate locating the position of the corner:

E-11	Standard Kent County Monument in Mon. Box
	C/L square cut top C/L N'y 60" conc. culv. N10°W 86.40'
	Cut new "X" top C/L N'y 60" conc. culv. N10°E 84.32'
	Nail & KC Remon. tag NW side 22" Apple N45°E 86.73'
	Nail & KC Remon. tag NE side CP Pole S45°E 68.98'
	Nail & KC Remon. tag NW side CP Pole S45°W 64.68'

On C/L Peach Ridge Ave. and 11 Mile Rd.



Signed by [Signature]
Surveyor's Michigan License No. 30077

Date 4/30/98