

SURVEY & REMONUMENTATION

MAR 08 1999

KENT COUNTY REMONUMENTATION

\$7.00
\$2.00

SECTION

LAND CORNER RECORDATION CERTIFICATE
Filing Requirement of Act 74, Mich. P.A. 1970

REG. OF DEEDS

STATE OF MICHIGAN
COUNTY OF KENT
RECEIVED FOR RECORD
98 MAR -5 AM 8:29

For corners in


KENT COUNTY (County)	Located In:	Corner Code #
1. Public Land Survey	T <u>9</u> N R <u>12</u> W	<u>F-7</u>
	T ___ R ___	_____
	T ___ R ___	_____
	T ___ R ___	_____
2. Property Controlling in Section	S ___ T ___ R ___	_____
	S ___ T ___ R ___	_____
3. Miscellaneous Property in Sec.	S ___ T ___ R ___	_____
	S ___ T ___ R ___	_____

10454
Register of Deeds Stamp & File Number

4. Lot No. _____, Recorded Plat _____
5. Private Claims _____

I, Kirk Breitels, in a field survey on Jan. 26, 19 98 do hereby state that under requirements of P.A. 74, Michigan P.A. of 1970, the corner points mentioned in lines 1 and 2 above were in conformance with regulations and rules therefore as required in the current manual of survey instructions of the United States Department of the Interior, Bureau of Land Management or by a decree of a Court of Law and for that the corner points mentioned in lines 3, 4 and 5 above were in conformance with the rules of the Michigan Board of Land Surveyors or by a Decree of a Court of Law; established, re-established, monumented, recovered, found as expressed below:

NOTE: Not more than 2 corners, all in the same town and range, may be recorded on this certificate.

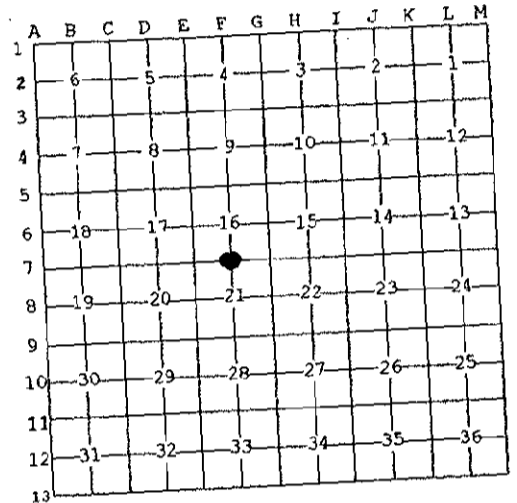

A. Description of original monument and accessories and/or subsequent restoration:

F-7	1837	GLO	Whitcomb	Set Post
	1974	Kent Co. Wits		Mon. Box
	1981	LCRC #3200	Nederveld	3/4" Round Iron in Mon. Box
	1982	LCRC #2629	Nederveld	Set Kent County Monument in Mon. Box
	1991	LCRC #6165	Byl	Kent County Monument in Mon. Box

P.A. 345 1990 KENT COUNTY
PEER APPROVED 2/19/98
CHAIRMAN [Signature]

The position of this corner was previously approved by the Kent County Remonumentation Peer Group, monumented by Gordon D. Nederveld on 1-25-82 and was recorded per LCRC #2629.

B. Description of corner evidence found and/or method applied in restoring or reestablishing corner:

F-7 Found Kent County Monument (Harrison) per witnesses from above LCRC as set by Gordon D. Nederveld in place of the 1/2" Round Iron he found inside a Mon. Box. Said Iron checks with Kent Co. Wits. and LCRC #3200.
LCRC #2629
Nail & Remon. tag fence post S10°W 62.06'
1/2" Round Iron N08°E 53.54'
1/2" Round Iron N36°W 55.65'
Top bolt SE leg CPC tower N62°E 71.98'
Head bolt NW leg CPC tower N40°E 69.36'
LCRC #6165
Nail & Remon. tag fence post S10°W 62.00'
1/2" Iron N08°E 53.54' Nail & Remon. tag 12" Pine S60°W 93.50'
1/2" Iron N36°W 55.65' Nail & Remon. tag 8" Pine S40°E 93.12'
Top bolt SE leg CPC tower N62°E 71.98'
Head bolt NW leg CPC tower N40°E 69.36'
Nail & Remon. tag CATV Pole N60°W 147.92'

The selected location is accepted by me and is generally accepted by professional surveyors as the best available evidence of the position of the original corner.

C. Description of monument for corner and accessories established to perpetuate locating the position of the corner:

F-7 Standard Kent County Monument in Mon. Box	S10°W	62.00'
Nail & KC Remon. tag W. side wood fence post	N08°E	53.54'
Top bolt (4' high) SE leg CP Co. tower	N36°W	55.65'
Head bolt (5 1/2' high) NW leg CP Co. tower	N60°W	147.75'
Nail & KC Remon. tag S. side P. Pole	S60°W	93.55'
Nail & KC Remon. tag NW side 16" Pine	S40°E	92.84'
Nail & KC Remon. tag N. side 12" Pine	N40°W	42.64'
Nail & KC Remon. tag E. side 6" Pine	N40°E	34.80'
Nail & KC Remon. tag W. side 6" Pine		



Signed by [Signature]
Surveyor's Michigan License No. 30077

Date 2/19/98