SURVEY & REMONUMENTATION

7/2

MAR 08 1999

SECTION

KENT COUNTY REMONUMENTATION

LAND CORNER RECORDATION CERTIFICATE
Filing Requirement of Act 74, Mich. P.A. 1970

STATE OF MICHIGAN
COUNTY OF KENT
RECEIVED FOR RECORD
98 OCT -7 AM 10: 15
REG. OF DEEDS

10714
Register of Deeds Stamp & File Number

For corners in
KENT COUNTY
(County)

	Located In:	Corner Code #
1. Public Land Survey	T9N R12W	F-8
	T___ R___	
	T___ R___	
	T___ R___	
2. Property Controlling in Section	S___ T___ R___	
	S___ T___ R___	
3. Miscellaneous Property in Sec.	S___ T___ R___	
	S___ T___ R___	

4. Lot No. _____ , Recorded Plat _____
5. Private Claims _____

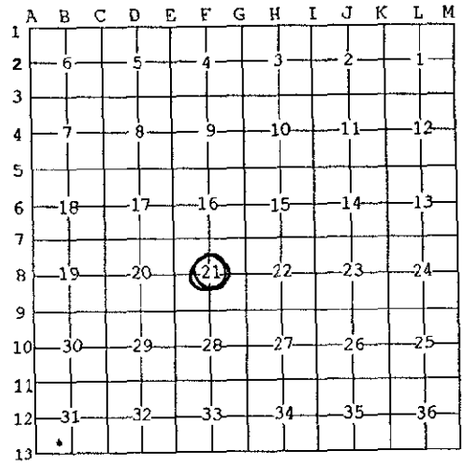

I, Kirk Breitels, in a field survey on Sept. 9, 19 98 do hereby state that under requirements of P.A. 74, Michigan P.A. of 1970, the corner points mentioned in lines 1 and 2 above were in conformance with regulations and rules therefore as required in the current manual of survey instructions of the United States Department of the Interior, Bureau of Land Management or by a decree of a Court of Law and /or that the corner points mentioned in lines 3, 4 and 5 above were in conformance with the rules of the Michigan Board of Land Surveyors or by a Decree of a Court of Law; established, re-established, monumented, recovered, found as expressed below:

NOTE: Not more than 2 corners, all in the same town and range, may be recorded on this certificate.

A. Description of original monument and accessories and/or subsequent restoration:

F-8 1837	GLO	Not Set
	1919-53 Williams & Works	Point - Boat Spike top of fence post Meas. 2656' South of N 1/4 corner Meas. 2652' West of E 1/4 corner
	Kent Co. Wits	No information

P.A. 345 1990 KENT COUNTY
PEER APPROVED 9/24/98
CHAIRMAN Larry Huber

B. Description of corner evidence found and/or method applied in restoring or reestablishing corner:
F-8 Found Iron Pipe on E-W field division ± at West side N-S Consumers Power tower line.

This Iron Pipe is 4.3' S & 0.4' E. from intersection of 1/4 lines. Meas. 2664.46' to E 1/4 cor. & 2653.42 to N 1/4 cor.

Since there is no record of this Iron being the corner - Established and Used Intersection of 1/4 lines as corner.

The Intersection of 1/4 lines is accepted by me and is generally accepted by professional surveyors as the best available evidence of the position of the corner.

C. Description of monument for corner and accessories established to perpetuate locating the position of the corner:
F-8 Set Standard Kent County Monument at the Intersection of 1/4 lines.

Nail & KC Remon. tag W. side 12" Elm	S00°W	58.06'
Nail & KC Remon. tag SW side 6" Apple	S50°E	71.41'
Nail & KC Remon. tag N. side 16" Stump	S85°E	37.93'
Top C/L bolt at S. end SE corner CP Co. tower	N55°E	67.32'

Pinched Pipe - East 67.32'
Iron Pipe - South 4.35'
On tree row to South and field division East & West ±

STATE OF MICHIGAN
KIRK BREITELS
LAND SURVEYOR
NO
30077
LICENSED LAND SURVEYOR

Signed by Kirk Breitels
Surveyor's Michigan License No. 30077

Date 9/25/98

FORM APPROVED BY MICHIGAN STATE BOARD OF PROFESSIONAL SURVEYORS, JAN. 28, 1971
REVISED MAY 14, 1975
REVISED JAN., 1983
REVISED OCT., 1995