

MAR 08 1999

SECTION

KENT COUNTY REMONUMENTATION

LAND CORNER RECORDATION CERTIFICATE  
Filing Requirement of Act 74, Mich. P.A. 1970

For corners in  
KENT COUNTY  
(County)

Located In:	Corner Code #
T 9N R 12W	F-12
T R	
T R	
T R	
T R	
S T R	
S T R	
S T R	
S T R	

- Public Land Survey
- Property Controlling in Section
- Miscellaneous Property in Sec.

STATE OF MICHIGAN  
COUNTY OF KENT  
RECEIVED FOR RECORD  
98 OCT -7 AM 10:15  
REG. OF DEEDS  
*Luis J. Bond*

10716

Register of Deeds Stamp & File Number

- Lot No. \_\_\_\_\_, Recorded Plat \_\_\_\_\_
- Private Claims \_\_\_\_\_

I, Kirk Breitels, in a field survey on Aug. 21, 1998 do hereby state that under requirements of P.A. 74, Michigan P.A. of 1970, the corner points mentioned in lines 1 and 2 above were in conformance with regulations and rules therefore as required in the current manual of survey instructions of the United States Department of the Interior, Bureau of Land Management or by a decree of a Court of Law and /or that the corner points mentioned in lines 3, 4 and 5 above were in conformance with the rules of the Michigan Board of Land Surveyors or by a Decree of a Court of Law; established, re-established, monumented, recovered, found as expressed below:

	A	B	C	D	E	F	G	H	I	J	K	L	M
1													
2	6		5		4		3		2		1		
3													
4	7		8		9		10		11		12		
5													
6	18		17		16		15		14		13		
7													
8	19		20		21		22		23		24		
9													
10	30		29		28		27		26		25		
11													
12	31		32		33		34		35		36		
13													

NOTE: Not more than 2 corners, all in the same town and range, may be recorded on this certificate.

A. Description of original monument and accessories and/or subsequent restoration:

F-12 1837 GLO Williams & Works Kent Co. Wits Not Set No information No information

P.A. 345 1990 KENT COUNTY  
PEER APPROVED 9/24/98  
CHAIRMAN [Signature]

B. Description of corner evidence found and/or method applied in restoring or reestablishing corner:


F-12 Found Rerod (no cap) on West line Consumers Power Co. right-of-way (also found Rerod 66.02' East on East side of Consumers Power Co. right-of-way. There is no survey information per Consumers Power Co.

Said Rerod is 0.6' N. and 0.3' West of the intersection of 1/4 lines. However, this Rerod does not fit described measurements of parcels in the SW 1/4 and SE 1/4 - measurements fit Intersection of 1/4 lines better. There are no surveys recorded to support anything else other than Intersection of 1/4 lines.

The Intersection of 1/4 lines is accepted by me and is generally accepted by professional surveyors as the best available evidence of the position of the corner.

C. Description of monument for corner and accessories established to perpetuate locating the position of the corner:

F-12 Set Standard Kent County Monument at the Intersection of 1/4 lines.  
C/L 2" Apple Tree N25°W 3.2'  
C/L 2" Apple Tree N85°E 18.5'  
NW cor. NW leg to CP Co. tower N55°E 53.98'  
Rerod N20°W 0.69'  
Rerod East 65.76'

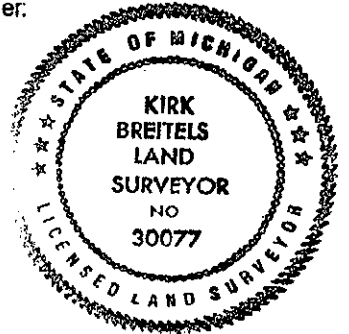

Signed by [Signature]  
Surveyor's Michigan License No. 30077

Date 9/25/98