

\$7.00
\$2.00

MAR 08 1999

KENT COUNTY REMONUMENTATION

STATE OF MICHIGAN
COUNTY OF KENT
RECEIVED FOR RECORD

98 JUL 14 AM 9:54

SECTION

LAND CORNER RECORDATION CERTIFICATE
Filing Requirement of Act 74, Mich. P.A. 1970

For corners in
KENT COUNTY

Luis J. Bond
REG. OF DEEDS


(County)	Located In:	Corner Code #
1. Public Land Survey	T ^{9N} R ^{12W}	G-4
	T R	
	T R	
	T R	
2. Property Controlling in Section	S T R	
	S T R	
3. Miscellaneous Property in Sec.	S T R	
	S T R	

10657

Register of Deeds Stamp & File Number

4. Lot No. _____, Recorded Plat _____
5. Private Claims _____

I, Kirk Breitels, in a field survey on May 5, 1998 do hereby state that under requirements of P.A. 74, Michigan P.A. of 1970, the corner points mentioned in lines 1 and 2 above were in conformance with regulations and rules therefore as required in the current manual of survey instructions of the United States Department of the Interior, Bureau of Land Management or by a decree of a Court of Law and /or that the corner points mentioned in lines 3, 4 and 5 above were in conformance with the rules of the Michigan Board of Land Surveyors or by a Decree of a Court of Law; established, re-established, monumented, recovered, found as expressed below:

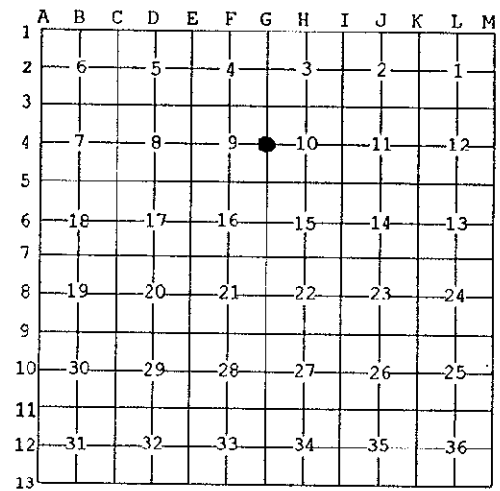

NOTE: Not more than 2 corners, all in the same town and range, may be recorded on this certificate.

A. Description of original monument and accessories and/or subsequent restoration:

G-4	1837	GLO	Whitcomb	Set Post
	1963	Kent Co. Wits		"T" Iron
	1980	LCRC #1323	Nelson	3/4" Steel Bar
	1982	LCRC #2947	Merdzinski	Set Kent County Monument
	1991	LCRC #6171	Byl	Kent County Monument

P.A. 345 1990 KENT COUNTY
PEER APPROVED 6/25/98
CHAIRMAN *[Signature]*

The position of this corner was previously approved by the Kent County Remonumentation Peer Group, monumented by John A. Merdzinski on 7-1-82 and was recorded per LCRC #2947.

B. Description of corner evidence found and/or method applied in restoring or reestablishing corner:

LCRC #2947	LCRC #6171
Nail & Remon. tag 8" Locust S80°E 22.16'	Nail & Remon. tag 32" Maple N10°W 131.75'
Nail & Remon. tag P & T Pole S25°W 177.15'	C/L E. end 18" conc. culv. S12°E 93.15'
Nail & Remon. tag 30" Maple N10°W 131.75'	C/L S. end 18" conc. culv. N40°W 25.75'
E. end 18" conc. culv. S12°E 93.60'	Nail & Remon. tag P. Pole N20°W 146.56'
S. end 18" conc. culv. N40°W 25.75'	Nail & Remon. tag 12" Elm S60°E 95.02'
	Nail & Remon. tag 12" Cherry S70°E 84.57'

The selected location is accepted by me and is generally accepted by professional surveyors as the best available evidence of the position of the original corner.

C. Description of monument for corner and accessories established to perpetuate locating the position of the corner:

G-4 Standard Kent County Monument	
Nail & KC Remon. tag E. side 34" Maple	N10°W 131.75'
C/L East end 18" concrete culvert	S12°E 93.15'
C/L South end 12" "concrete culvert	N40°W 25.98'
Nail & KC Remon. tag E. side P. Pole	N20°W 146.56'
Nail & KC Remon. tag S. side 12" stump	S60°E 94.98'
Nail & KC Remon. tag S. side 6" Elm	S75°E 54.40'
C/L N-S asphalt road is 2' East	
On fence line to West	



Signed by *[Signature]*
Surveyor's Michigan License No. 30077

Date 6/25/98