$7.00
$2.00

KENT COUNTY REMONUMENTATION

LAND CORNER RECORDATION CERTIFICATE
Filing Requirement of Act 74, Mich. P.A. 1970

1999 DEC 30 AM 9:20
COUNTY OF KENT
RECEIVED FOR RECORD
REG. OF DEEDS

For corners in
KENT COUNTY
(County)

	Located In:		Corner Code #
			Sparta Twp.
1. Public Land Survey		T 9N R 12W	G-11
		T___ R___	
		T___ R___	
		T___ R___	
2. Property Controlling	S___	T___ R___	
in Section	S___	T___ R___	
3. Miscellaneous	S___	T___ R___	
Property in Sec.	S___	T___ R___	

11676
Register of Deeds Stamp & File Number

4. Lot No. _____, Recorded Plat _____
5. Private Claims _____

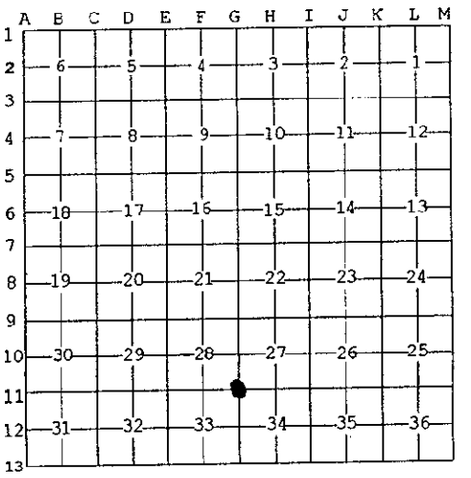

I, Kirk Breitels, in a field survey on Dec. 13, 19 99 do hereby state that under requirements of P.A. 74, Michigan P.A. of 1970, the corner points mentioned in lines 1 and 2 above were in conformance with regulations and rules therefore as required in the current manual of survey instructions of the United States Department of the Interior, Bureau of Land Management or by a decree of a Court of Law and /or that the corner points mentioned in lines 3, 4 and 5 above were in conformance with the rules of the Michigan Board of Land Surveyors or by a Decree of a Court of Law; established, re-established, monumented, recovered, found as expressed below:

NOTE: Not more than 2 corners, all in the same town and range, may be recorded on this certificate.

A. Description of original monument and accessories and/or subsequent restoration:

G-11 Kent County Monument, LCRC #10625

"X" cut on top of concrete culvert	N25°E	75.22'
"X" cut on top of concrete culvert	N15°W	72.53'
Nail & KC Remon. tag NW side 14" Ash	N50°E	80.38'
Nail & KC Remon. tag E. side 10" Ash	S10°E	39.68'
Nail & KC Remon. tag W. side 15" Ash	S00°W	58.19'
Nail & KC Remon. tag W. side 10" Oak	S30°W	39.56'

C/L E-W blacktop road is 1.5' South
C/L blacktop road North is 4.5' East

P.A. 345 1990 KENT COUNTY
PEER APPROVED 4/30/98
CHAIRMAN

B. Description of corner evidence found and/or method applied in restoring or reestablishing corner:

G-11 Found Kent County Monument

All witnesses above OK

SURVEY & REMONUMENTATION
MAY 22 2000
SECTION

C. Description of monument for corner and accessories established to perpetuate locating the position of the corner:

G-11 RESET Standard Kent County Monument in MON. BOX

"X" cut on top of concrete culvert	N25°E	75.22'
"X" cut on top of concrete culvert	N15°W	72.53'
Nail & KC Remon. tag NW side 14" Ash	N50°E	80.38'
Nail & KC Remon. tag E. side 10" Ash	S10°E	39.68'
Nail & KC Remon. tag W. side 15" Ash	S00°W	58.19'
Nail & KC Remon. tag W. side 10" Oak	S30°W	39.56'

C/L E-W blacktop road is 1.5' South
C/L blacktop road North is 4.5' East

STATE OF MICHIGAN
KIRK BREITELS
LAND SURVEYOR
NO 30077
LICENSED LAND SURVEYOR

Signed by _____ Date 12/28/99
Surveyor's Michigan License No. 30077

FORM APPROVED BY MICHIGAN STATE BOARD OF PROFESSIONAL SURVEYORS, JAN. 28, 1971
REVISED MAY 14,1975
REVISED JAN., 1983
REVISED OCT., 1995