

\$7.00
 \$2.00
 SEP 18 1995

KENT COUNTY REMONUMENTATION

COMMISSION

LAND CORNER RECORDATION CERTIFICATE
 Filing Requirement of Act 74, Mich. P.A. 1970

For corners in
KENT COUNTY
 (County)

Located In:

Corner Code #

1. Public Land Survey	T	9N	R	12W	G-13
	T		R		
	T		R		
	T		R		
2. Property Controlling in Section	S		T	R	
	S		T	R	
3. Miscellaneous Property in Section	S		T	R	
	S		T	R	

STATE OF MICHIGAN
 COUNTY OF KENT
 RECEIVED FOR RECORD
 95 JUN 29 PM 12:00
 REG. OF DEEDS
 852

Register of Deeds Stamp & File Number

4. Lot No. _____, Recorded Plat _____
 5. Private Claims _____

A	B	C	D	E	F	G	H	I	J	K	L
2	6	5	4	3	2	1					
3											
4	7	8	9	10	11	12					
5											
6	18	17	16	15	14	13					
7											
8	19	20	21	22	23	24					
9											
10	30	29	28	27	26	25					
11											
12	31	32	33	34	35	36					
13											

I, Kirk Breitels, in a field survey on March 10, 1995, do hereby certify that under requirements of P.A. 74, Michigan P.A. of 1970, the corner points mentioned in lines 1 and 2 above were in conformance with regulations and rules therefore as required in the current manual of survey instructions of the United States Department of the Interior, Bureau of Land Management or by a decree of a Court of Law and/or that the corner points mentioned in lines 3, 4 and 5 above were in conformance with the rules of the Michigan Board of Professional Surveyors or by a Decree of a Court of Law; established, re-established, monumented, re-monumented, recovered, found as expressed below:

NOTE: Not more than 4 corners, all in the same town and range, may be recorded on this certificate.

A. Description of original monument and accessories and/or subsequent restoration:

G-13	1837	GLO	Brookfield	Set Post
	1967	Kent Co. Wit.		Conc. Mon. in mon. box
	1984	LCRC #4079	Kolehouse	Set Kent County Monument in mon. box
	1991	LCRC #6178	Byl	Kent County Monument in mon. box

The position of this corner was previously approved by the Kent County Remonumentation Peer Group, monumented by Randy J. Kolehouse on 11/16/84 and was recorded per LCRC #4079

B. Description of corner evidence found and/or method applied in restoring or reestablishing corner:

G-13 Found standard Kent Co. Mon. (Harrison) per witnesses from above LCRC as set by Randy J. Kolehouse in place of the 1/2" Iron he found over a 1" Iron inside a mon. box. Both Irons check with Kent Co. Wit.

LCRC #6178 & #4079

Nail & KC Remon. tag NE side P. Pole	N50°W	82.60'
Nail & KC Remon. tag SE side P. Pole	N55°E	138.85'
C/L steel fence post	N00°E	39.75'
Kent Co. Mon. (G-1, T8N, R12W)	East	98.75'

P.A. 345 1990 KENT COUNTY


PEER APPROVED 6/22/95
 CHAIRMAN Randy Kolehouse

The selected location is accepted by me and is generally accepted by professional surveyors as the best available evidence of the position of the original corner.

C. Description of monument for corner and accessories established to perpetuate locating the position of the corner:

G-13 Standard Kent County Monument

Nail & KC Remon. tag SE side P. Pole	N70°E	138.45'	(new pole)
Nail & KC Remon. tag N. side 28" Poplar	S75°W	104.66'	
Nail & KC Remon. tag NE side P. Pole	N60°W	80.70'	(new pole)
C/L steel fence post	N00°E	39.75'	
Kent Co. Mon. (G-1, T8N, R12W)	East	98.65'	

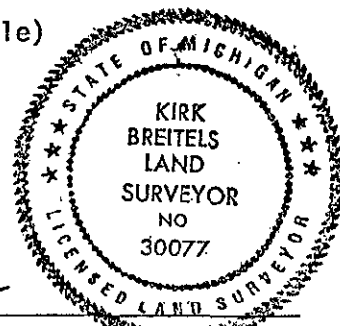

Signed by Kirk Breitels
 Surveyor's Michigan License No. 30077

Date 6/22/95