

SURVEY & REMONUMENTATION

\$7.00
\$2.00

MAR 08 1999

KENT COUNTY REMONUMENTATION

SECTION

LAND CORNER RECORDATION CERTIFICATE
Filing Requirement of Act 74, Mich. P.A. 1970

STATE OF MICHIGAN
COUNTY OF KENT
RECEIVED FOR RECORD
98 MAY 21 AM 8:33
REG. OF DEEDS
Lucy Spauld

For corners in
KENT COUNTY
(County)

Located In: Corner Code #


- | | | |
|------------------------------------|----------------------------|-------|
| 1. Public Land Survey | T <u>9</u> N R <u>12</u> W | H-9 |
| | T _____ R _____ | _____ |
| | T _____ R _____ | _____ |
| | T _____ R _____ | _____ |
| 2. Property Controlling in Section | S _____ T _____ R _____ | _____ |
| | S _____ T _____ R _____ | _____ |
| 3. Miscellaneous Property in Sec. | S _____ T _____ R _____ | _____ |
| | S _____ T _____ R _____ | _____ |

10628
Register of Deeds Stamp & File Number

4. Lot No. _____, Recorded Plat _____
5. Private Claims _____

I, Kirk Breitels, in a field survey on April 7, 1998, do hereby state that under requirements of P.A. 74, Michigan P.A. of 1970, the corner points mentioned in lines 1 and 2 above were in conformance with regulations and rules therefore as required in the current manual of survey instructions of the United States Department of the Interior, Bureau of Land Management or by a decree of a Court of Law and/or that the corner points mentioned in lines 3, 4 and 5 above were in conformance with the rules of the Michigan Board of Land Surveyors or by a Decree of a Court of Law; established, re-established, monumented, recovered, found as expressed below:

NOTE: Not more than 2 corners, all in the same town and range, may be recorded on this certificate.

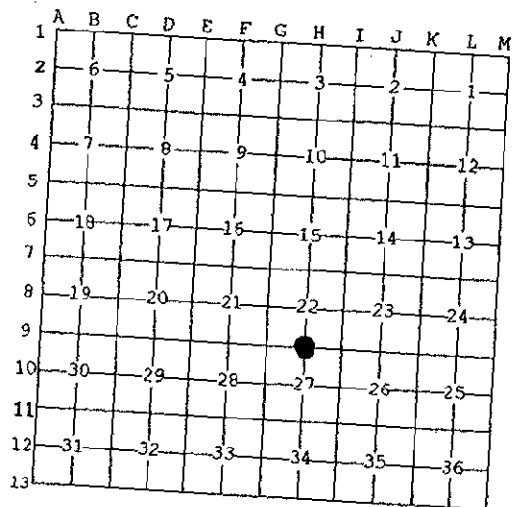

P.A. 345 1990 KENT COUNTY
PEER APPROVED 4/30/98
CHAIRMAN [Signature]

A. Description of original monument and accessories and/or subsequent restoration:

- | | | |
|-----------------|------------|--------------------------|
| H-9 1837 GLO | Whitcomb | Set Post |
| Kent Co. Wits | | Boat Spike |
| 1972 LCRC #205 | Bonnema | Boat Spike |
| 1972 LCRC #296 | VanKooten | Boat Spike |
| 1982 LCRC #2937 | Merdzinski | Set Kent County Monument |
| 1995 LCRC #8295 | Breitels | Kent County Monument |

The position of this corner was previously approved by the Kent County Remonumentation Peer Group, monumented by John A. Merdzinski on 4-15-82 and was recorded per LCRC#2937.

B. Description of corner evidence found and/or method applied in restoring or reestablishing corner:

H-9 Found Kent County Monument (Harrison) per witnesses from above LCRC as set by John A. Merdzinski in place of the Boat Spike over a 1" Iron he found over a Stone. All check with Kent Co. Wit. and LCRC's #205 & #296.
LCRC #2937

- | | | | | | |
|-------------------------------|-------|--------|-------------------------------|-------|--------|
| Nail & Remon. tag 14" Maple | North | 43.50' | Nail & Remon. tag 22" Maple | N00°E | 43.30' |
| Nail & Remon. tag 16" Maple | N60°W | 83.11' | Nail & Remon. tag 27" Maple | N60°W | 83.10' |
| Nail & Remon. tag P. Pole | S35°W | 50.63' | Nail & Remon. tag P. Pole | S35°W | 50.63' |
| Nail & Remon. tag 16" Hickory | S50°E | 41.44' | "X" cut on E. end conc. culv. | S20°E | 58.55' |
| "X" cut on E. end conc. culv. | S20°E | 58.55' | On C/L blacktop road to South | | |

The selected location is accepted by me and is generally accepted by professional surveyors as the best available evidence of the position of the original corner.

C. Description of monument for corner and accessories established to perpetuate locating the position of the corner:

- H-9 Standard Kent County Monument
- | | | |
|--|-------|--------|
| Nail & KC Remon. tag E. side 22" Maple | N00°E | 43.30' |
| Nail & KC Remon. tag SW side 27" Maple | N60°W | 83.10' |
| Nail & KC Remon. tag NW side P. Pole | S35°W | 50.63' |
| "X" cut on E. end 12" concrete culvert | S20°E | 58.55' |
- On C/L blacktop road to South
C/L blacktop road E-W is 1/5' ± North.



Signed by [Signature]
Surveyor's Michigan License No. 30077

Date 4/30/98