

SURVEY & REMONUMENTATION

MAR 08 1999

KENT COUNTY REMONUMENTATION

LAND CORNER RECORDATION CERTIFICATE
Filing Requirement of Act 74, Mich. P.A. 1970

SECTION _____

\$7.00
\$2.00

For corners in

KENT COUNTY
(County)

Located In:	Corner Code #
T <u>9</u> N R <u>12</u> W	<u>1-9</u>
T _____ R _____	_____
T _____ R _____	_____
T _____ R _____	_____
S _____ T _____ R _____	_____
S _____ T _____ R _____	_____
S _____ T _____ R _____	_____
S _____ T _____ R _____	_____

1. Public Land Survey

2. Property Controlling in Section

3. Miscellaneous Property in Sec.

4. Lot No. _____, Recorded Plat _____
5. Private Claims _____

I, Kirk Breiteis, in a field survey on Jan. 6, 1998 do hereby state that under requirements of P.A. 74, Michigan P.A. of 1970, the corner points mentioned in lines 1 and 2 above were in conformance with regulations and rules therefore as required in the current manual of survey instructions of the United States Department of the Interior, Bureau of Land Management or by a decree of a Court of Law and for that the corner points mentioned in lines 3, 4 and 5 above were in conformance with the rules of the Michigan Board of Land Surveyors or by a Decree of a Court of Law; established, re-established, monumented, recovered, found as expressed below:

NOTE: Not more than 2 corners, all in the same town and range, may be recorded on this certificate.

A. Description of original monument and accessories and/or subsequent restoration:

I-9	1837	GLO	Whitcomb	Set Post
	1971	Kent Co. Wits		Iron in Mon. Box
	1972	LCRC #205	Bonnema	Bolt in Mon. Box
	1972	LCRC #296	VanKooten	Spike in Mon. Box
	1982	LCRC #2637	Nederveld	Set Kent County Monument in Mon. Box
	1995	LCRC #8304	Breiteis	Kent County Monument

The position of this corner was previously approved by the Kent County Remonumentation Peer Group, monumented by Gordon D. Nederveld on 2-19-82 and was recorded per LCRC #2637.

B. Description of corner evidence found and/or method applied in restoring or reestablishing corner:

I-9 Found Kent County Monument (Harrison) per witnesses from above LCRC as set by Gordon D. Nederveld in place of the Bolt he found inside a Mon. Box. Said Bolt checks with Kent Co. Wits. and LCRC's #205 & #296.

LCRC #2637		LCRC #8304	
Nail & Remon. tag P. Pole	N32°E 56.32'	Nail & Remon. tag P. Pole	N32°W 56.38'
Nail & Remon. tag 14" Oak	N40°E 94.50'	Nail & Remon. tag T. Pole	S34°W 76.45'
Nail & Remon. tag P. Pole	S48°E 62.78'	Nail & Remon. tag P. Pole	S40°E 56.18'
Nail & Remon. tag T. Pole	S34°W 76.45'	Nail & Remon. tag P. Pole	N40°E 73.34'

The selected location is accepted by me and is generally accepted by professional surveyors as the best available evidence of the position of the original corner.

C. Description of monument for corner and accessories established to perpetuate locating the position of the corner:

I-9 Standard Kent County Monument	
Nail & KC Remon. tag NE side P. Pole	N32°W 56.38'
C/L Telephone Manhole	S50°W 68.20'
Nail & KC Remon. tag NW side T. Pole	S34°W 76.38'
Nail & KC Remon. tag SW side P. Pole	S40°E 56.15'
C/L top of Fire Hydrant	N70°E 77.42'
Nail & KC Remon. tag NW side P. Pole	N40°E 73.34'




Signed by Kirk Breiteis
Surveyor's Michigan License No. 30077

Date 2/19/98

STATE OF MICHIGAN
COUNTY OF KENT
RECEIVED FOR RECORD
98 MAR -5 AM 8:30
REG. OF DEEDS
Lucy [Signature]

10476
Register of Deeds Stamp & File Number

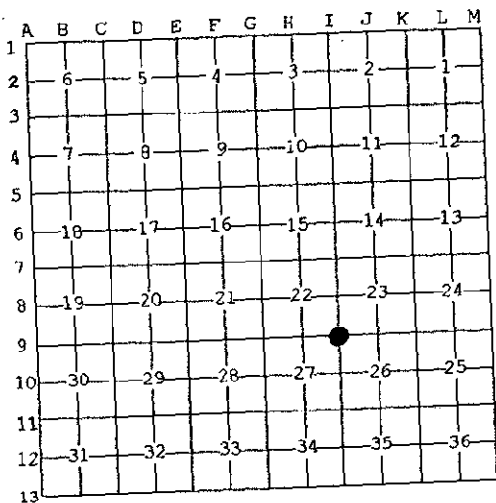

P.A. 345 1990 KENT COUNTY
PEER APPROVED 2/19/98
CHAIRMAN [Signature]