

OCT 28 1994

LAND CORNER RECORDATION CERTIFICATE
 Filing Requirement of Act 74, Mich. P.A. 1970

STATE OF MICHIGAN
 COUNTY OF KENT
 RECEIVED FOR RECORD

94 AUG 24 AM 11:52

For corners in **COMMISSION**

Kent (County) Located In: Sparta Twp. Corner Code #

1. Public Land Survey	T 9N	R 12W	J-8
	T	R	cen. sec. 23
	T	R	
	T	R	
2. Property Controlling In Section	S	T	R
	S	T	R
3. Miscellaneous Property in Sec.	S	T	R
	S	T	R

W. J. Bond
 REG. OF DEEDS

6972

Register of Deeds Stamp & File Number

4. Lot No. _____, Recorded Plat _____
 5. Private Claims _____

I, Wallace E. Glaza, in a field survey on August 12, 19 94, do hereby certify that under requirements of P.A. 74, Michigan P.A. of 1970, the corner points mentioned in lines 1 and 2 above were in conformance with regulations and rules therefore as required in the current manual of survey instructions of the United States Department of the Interior, Bureau of Land Management or by a decree of a Court of Law and/or that the corner points mentioned in lines 3, 4 and 5 above were in conformance with the rules of the Michigan Board of Land Surveyors or by a Decree of a Court of Law; established, re-established, monumented, re-monumented, recovered, found as expressed below:

A	B	C	D	E	F	G	H	I	J	K	L	M
2	6	5	4	3	2	1						
3												
4	7	8	9	10	11	12						
5												
6	16	17	16	15	14	13						
7												
8	19	20	21	22	23	24						
9												
10	30	29	28	27	26	25						
11												
12	31	32	33	34	35	36						
13												

NOTE: Not more than 4 corners, all in the same town and range, may be recorded on this certificate.

A. Description of original monument and accessories and/or subsequent restoration:

L.C.R.C. No. 925 (Moore & Bruggink)	L.C.R.C. No. 986 (MVK)
Found iron by witness from former survey	Found boat spike by previous witness
1) Nail & cap in 22" cottonwood SSW 58.3'	1) PK in N side 42" maple ESE 57.98'
2) Nail & cap in 22" maple ESE 37.6'	2) PK in N side 24" maple ESE 38.59'
3) Nail & cap in twin 2" maple SE 44.6'	3) PK in E side T-pole SSW 97.89'
	4) 1" iron West 33.03'

B. Description of corner evidence found and/or method applied in restoring or reestablishing corner:

J-8 (Center of Section 23, T9N, R12W, Sparta Township, Kent County, Michigan)
 Found boat spike with 1" iron pipe below. Existing corner is 1.19' South and 0.21' West of intersection of 1/4 lines. Accepted location of spike and pipe as center of Section. Replaced spike and pipe with standard 4" x 30" Kent County Monument. (Harrison)


West 1/4 corner to center - 2615.69'
 North 1/4 corner to center - 2660.91'
 East 1/4 corner to center - 2607.28
 South 1/4 corner to center - 2649.65'

P.A. 345 1990 KENT COUNTY
 PEER APPROVED 7/28/94
 CHAIRMAN *Harvey Huber*

C. Description of monument for corner and accessories established to perpetuate locating the position of the corner:

J-8 (4" x 30" Kent County Monument)

1) Remon tag & nail in N side 22" maple	S80°E	38.13'
2) Remon tag & nail in SE side 14" willow	N30°E	79.90'
3) Remon tag & nail in E side 10" willow	N30°W	75.60'
4) Remon tag & nail in E side T-pole	S15°W	97.95'
5) Centerline North-South road	East	3.50'
6) Fence to East on line ±		

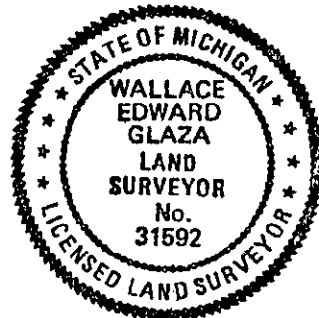

Signed by Wallace E. Glaza Date 8-16-94
 Glaza & Associates, Inc. 31592
 Surveyor's Michigan License No. _____