SURVEY & REMONUMENTATION

$7.00 $2.00 MAR 08 1999 SECTION

KENT COUNTY REMONUMENTATION

LAND CORNER RECORDATION CERTIFICATE
Filing Requirement of Act 74, Mich. P.A. 1970

STATE OF MICHIGAN COUNTY OF KENT RECEIVED FOR RECORD 98 MAR -5 AM 8:31 REG. OF DEEDS

For corners in KENT COUNTY (County) Located In: Corner Code #

1. Public Land Survey		T 9N	R 12W	M-2
		T___	R___	common with
		~~T 9N~~	~~R 11W~~	~~A-2~~
		T___	R___	
2. Property Controlling	S___	T___	R___	
in Section	S___	T___	R___	
3. Miscellaneous	S___	T___	R___	
Property in Sec.	S___	T___	R___	

10496

Register of Deeds Stamp & File Number

4. Lot No. _____, Recorded Plat _____
5. Private Claims _____

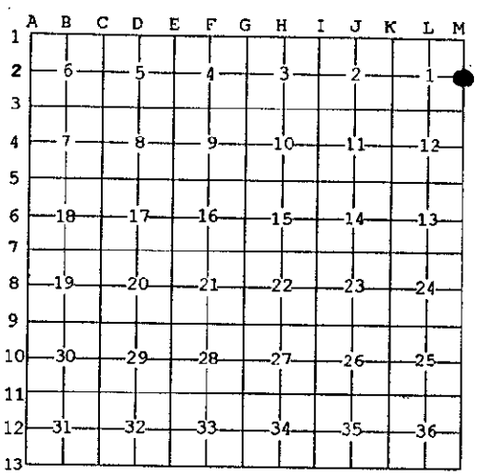

I, Kirk Breitels, in a field survey on Jan. 5, 1998 do hereby state that under requirements of P.A. 74, Michigan P.A. of 1970, the corner points mentioned in lines 1 and 2 above were in conformance with regulations and rules therefore as required in the current manual of survey instructions of the United States Department of the Interior, Bureau of Land Management or by a decree of a Court of Law and /or that the corner points mentioned in lines 3, 4 and 5 above were in conformance with the rules of the Michigan Board of Land Surveyors or by a Decree of a Court of Law; established, re-established, monumented, recovered, found as expressed below:

NOTE: Not more than 2 corners, all in the same town and range, may be recorded on this certificate.

P.A. 345 1990 KENT COUNTY
PEER APPROVED 2/19/98
CHAIRMAN Harry Huber

A. Description of original monument and accessories and/or subsequent restoration:

M-2	1837	GLO	Brookfield	Set Post
		Kent Co. Wits		Iron in Mon. Box
	1972	LCRC #357	Spicer	1 ½" Iron in Mon. Box
	1982	LCRC #3193	Bonnema	Set Kent County Monument in Mon. Box
	1995	LCRC #8329	Breitels	Kent County Monument

The position of this corner was previously approved by the Kent County Remonumentation Peer Group, monumented by Douglas W. Bonnema on 12-9-82 and was recorded per LCRC#3193.

B. Description of corner evidence found and/or method applied in restoring or reestablishing corner:

M-2 Found Kent County Monument (Harrison) per witnesses from above LCRC as set by Douglas W. Bonnema in place of the ½" Iron he found over a large rock inside a Mon. Box. Said Iron checks with Kent Co. Wits. and LCRC #357.

LCRC #3193		LCRC #8329	
Nail & Remon. tag P. Pole	S10°W 60.0'	Nail & Remon. tag P. Pole	S10°W 59.99'
Nail & Remon. tag 12" Pine	S60°E 42.20'	Nail & Remon. tag 18" Pine	S60°E 42.24'
Nail & Remon. tag 8" Pine	S65°W 78.85'	Nail & Remon. tag 14" Pine	S65°W 78.44'
Capped Exxel rerod at base CP tower	N30°E 192.0'	Capped Exxel rerod at base CP tower	N30°E 192.0'

C/L E-W blacktop road is North 2.8'

The selected location is accepted by me and is generally accepted by professional surveyors as the best available evidence of the position of the original corner.

C. Description of monument for corner and accessories established to perpetuate locating the position of the corner:

M-2 Standard Kent County Monument in Mon. Box

Nail & KC Remon. tag E. side P. Pole	S10°W	59.99'
Nail & KC Remon. tag NE side 20" Pine	S60°E	42.24'
Nail & KC Remon. tag N. side 16" Pine	S65°W	78.39'
Capped Exxel rerod in ground at base of S'ly leg CP tower	N30°E	192.0'
SE face of gas line marker	N45°W	44.36'

C/L E-W blacktop road is North 2.8'

STATE OF MICHIGAN KIRK BREITELS LAND SURVEYOR NO 30077 LICENSED LAND SURVEYOR

Signed by Kirk Breitels Date 2/19/98

Surveyor's Michigan License No. 30077

FORM APPROVED BY MICHIGAN STATE BOARD OF PROFESSIONAL SURVEYORS, JAN. 26, 1971
REVISED MAY 14,1975
REVISED JAN., 1983
REVISED OCT., 1905