

97.00  
2/20/99

# KENT COUNTY REMONUMENTATION

## LAND CORNER RECORDATION CERTIFICATE Filing Requirement of Act 74, Mich. P.A. 1970

For corners in

KENT COUNTY

(County)

Located In:

Corner Code #

1. Public Land Survey

T 9N R 12W

Sparta Twp.

A-4

T \_\_\_\_\_ R \_\_\_\_\_

T \_\_\_\_\_ R \_\_\_\_\_

T \_\_\_\_\_ R \_\_\_\_\_

2. Property Controlling  
in Section

S \_\_\_\_\_ T \_\_\_\_\_ R \_\_\_\_\_

S \_\_\_\_\_ T \_\_\_\_\_ R \_\_\_\_\_

3. Miscellaneous  
Property in Sec.

S \_\_\_\_\_ T \_\_\_\_\_ R \_\_\_\_\_

S \_\_\_\_\_ T \_\_\_\_\_ R \_\_\_\_\_

4. Lot No. \_\_\_\_\_, Recorded Plat \_\_\_\_\_

5. Private Claims \_\_\_\_\_

I, Kirk Breitels, in a field survey on Dec. 13, 1999 do hereby state that under requirements of P.A. 74, Michigan P.A. of 1970, the corner points mentioned in lines 1 and 2 above were in conformance with regulations and rules therefore as required in the current manual of survey instructions of the United States Department of the Interior, Bureau of Land Management or by a decree of a Court of Law and/or that the corner points mentioned in lines 3, 4 and 5 above were in conformance with the rules of the Michigan Board of Land Surveyors or by a Decree of a Court of Law, established, re-established, monumented, recovered, found as expressed below:

NOTE: Not more than 2 corners, all in the same town and range, may be recorded on this certificate.

A. Description of original monument and accessories and/or subsequent restoration:

A-4 Kent County Monument, LCRC #10652

Nail & OC Remon. tag NW face 28" Apple S60°E 109.50'

"X" on S. end 18" concrete culvert S65°E 48.07'

"I" (notch) on N. end 18" concrete culvert N60°E 51.08'

Nail & KC Remon. tag S. side P. Pole N65°E 135.65'

C/L street sign post N80°W 20.1'

Nail & OC Remon. tag W. side sign post S25°E 69.46'

Mon. is 2' E. and 5' S. of "X" asph. roads N-S & E.

B. Description of corner evidence found and/or method applied in restoring or reestablishing corner:

A-4 Found Kent County Monument

All witnesses above OK

SURVEY &  
REMONUMENTATION

MAY 22 2000

SECTION

C. Description of monument for corner and accessories established to perpetuate locating the position of the corner:

A-4 RESET Standard Kent County Monument in MON. BOX

Nail & OC Remon. tag NW face 28" Apple S60°E 109.50'

"X" on S. end 18" concrete culvert S65°E 48.07'

"I" (notch) on N. end 18" concrete culvert N60°E 51.08'

Nail & KC Remon. tag S. side P. Pole N65°E 135.65'

C/L street sign post N80°W 20.1'


Nail & OC Remon. tag W. side sign post S25°E 69.46'

Mon. is 2' E. and 5' S. of "X" asph. roads N-S & E.

Signed by Kirk Breitels

Date 12/28/99

Surveyor's Michigan License No. 30077

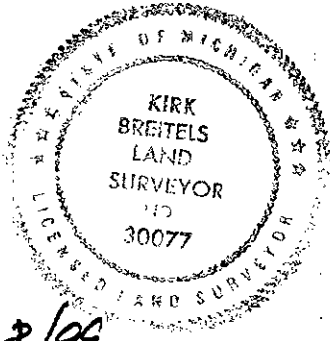

REG. OF DEEDS

1999 DEC 30 AM 9:20

RECEIVED FOR RECORD

11678

Register of Deeds Stamp & File Number

	A	B	C	D	E	F	G	H	I	J	K	L	M
1													
2	6		5		4		3		2		1		
3													
4	7		8		9		10		11		12		
5													
6	18		17		16		15		14		13		
7													
8	19		20		21		22		23		24		
9													
10	30		29		28		27		26		25		
11													
12	31		32		33		34		35		36		
13													

P.A. 345 1990 KENT COUNTY

PEER APPROVED 6/25/99

CHAIRMAN Kerry Huber