

\$7.00
\$2.00

SURVEY &
REMONUMENTATION

MAY 22 2000

LAND CORNER RECORDATION CERTIFICATE
Filing Requirement of Act 74, Mich. P.A. 1970
KENT COUNTY REMONUMENTATION

STATE OF MICHIGAN
COUNTY OF KENT
RECEIVED FOR RECORD
1999 DEC 27 AM 8:18

REG. OF DEEDS
[Signature]

11628

Register of Deeds Stamp & File Number

For corners in SECTION

Kent (County)	Located in:	Spencer Township	Corner Code #
1. Public Land Survey	T 10N	R 9W	A-13
	T	R	
	T	R	
	T	R	
2. Property Controlling in Section	S	T	R
	S	T	R
3. Miscellaneous Property in Sec.	S	T	R
	S	T	R

4. Lot No. _____, Recorded Plat _____

5. Private Claims _____


I, Randy Kolehouse, in a field survey on February 4 19 99, do hereby certify that under requirements of P.A. 74 Michigan P.A. of 1970, the corner points mentioned in lines 1 and 2 above were in conformance with regulations and rules therefore as required in the current manual of survey instructions of the United States Department of the Interior, Bureau of Land Management or by a decree of a Court of Law and/or that the corner points mentioned in lines 3, 4 and 5 above were in conformance with the rules of the Michigan Board of Land Surveyors or by a Decree of a Court of Law; established, re-established, monumented, re-monumented, recovered, found as expressed below:

NOTE: Not more than 4 corners, all in the same town and range, may be recorded on this certificate.

A. Description of original monument and accessories and/or subsequent restoration:

A-13	1837	G.L.O. Notes	Cathcart	Set Post
	N/A	Witness Map	K.C. Surveyor	N/A
	1876	Notes	Williams & Works	Stake (Oakfield Township)
	1968	Notes	Williams & Works	Set Iron (Oakfield Township)
	1984	L.C.R.C. #3999	John Bueche	Fnd. "T" Iron / Set K.C. Monument
	1988	L.C.R.C. #4791	John Bueche	Set K.C. Monument

P.A. 345 1990 KENT COUNTY,
PEER APPROVED 10/28/99
CHAIRMAN [Signature]

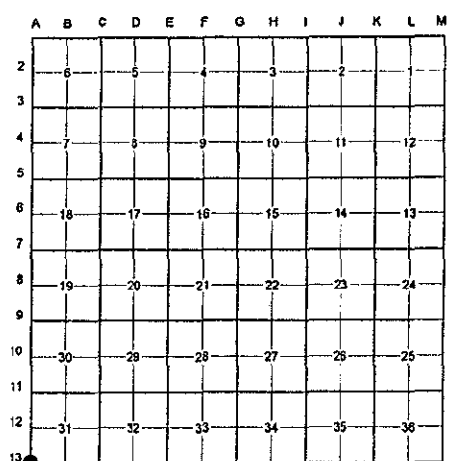

Note: This corner is common with M-13, T10N, R10W; M-1, T9N, R10W; and A-1, T9N, R9W.

This corner was originally approved by the Kent County Remonumentation Peer Group and monumented by John Bueche on 10/12/84 and was recorded per L.C.R.C. #3999.

B. Description of corner evidence found and/or method applied in restoring or reestablishing corner:

A-13 Found a Standard Kent County Monument on the C/L intersection of 16 Mile Road (gravel) running East and West and Keller Avenue (gravel) running North per L.C.R.C.'s #3999 and #4791 as set by John Bueche in place of a "T" iron he found which checked the notes of Williams & Works and the K.C. Surveyor's records.

L.C.R.C. #3999

L.C.R.C. #4791

K.C. Remon. tag & nail in E. side 34" Oak S 30° W 70.58'
K.C. Remon. tag & nail in S. side 14" Oak N 60° W 44.31'
K.C. Remon. tag & nail in W. side 15" Oak N 35° E 42.58'
K.C. Remon. tag & nail in S. side 10" Pine N 80° E 62.32'


K.C. Remon tag & nail in E sde 36" Oak S 30 W 70.58' (m. 70.56')
K.C. Remon tag & nail in S sde 16" Oak N 60 W 44.31' (m. 44.30')
K.C. Remon tag & nail in W sde 17" Oak N 35 E 42.58'
K.C. Remon tag & nail in S sde 12" Pine N 80 E 62.32' (m. 62.34')
On C/L gravel road E-W

The selected location is accepted by me and is generally accepted by professional surveyors as the best available evidence of the position of the original corner.

C. Description of monument for corner and accessories established to perpetuate locating the position of the corner:

A-13 Standard Kent County Monument

- Nail & K.C. remon. tag on W side 36" Oak S 15° E 29.61'
- Nail & K.C. remon. tag on E side 36" Oak S 30° W 70.56'
- Nail & K.C. remon. tag on S side 18" Oak N 60° W 44.30'
- Nail & K.C. remon. tag on W side 17" Oak N 35° E 42.58'
- Nail & K.C. remon. tag on S side 12" Pine N 80° E 62.34'
- On C/L "X" of gravel roads running E-W-N

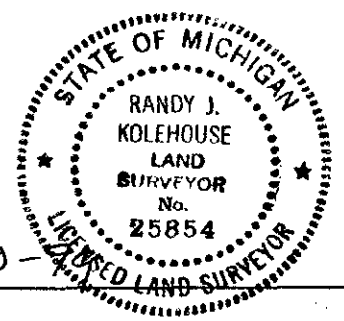

Signed by Randy J. Kolehouse
WILLIAMS & WORKS

Date 12-20-99

Surveyor's Michigan License No. 25854