

MAY 22 2000

LAND CORNER RECORDATION CERTIFICATE
Filing Requirement of Act 74, Mich. P.A. 1970
KENT COUNTY REMONUMENTATION

\$7.00
\$2.00

SECTION

For corners in

Table with columns: Kent (County), Located in: Spencer Township, Corner Code #. Rows include Public Land Survey, Property Controlling in Section, and Miscellaneous Property in Sec.

STATE OF MICHIGAN
COUNTY OF KENT
RECEIVED FOR RECORD
1999 DEC - 8 AM 10:01
REG. OF DEEDS

11528

Register of Deeds Stamp & File Number


4. Lot No. Recorded Plat
5. Private Claims

I, Randy Kolehouse, in a field survey on August 12, 1999, do hereby certify that under requirements of P.A. 74 Michigan P.A. of 1970, the corner points mentioned in lines 1 and 2 above were in conformance with regulations and rules therefore as required in the current manual of survey instructions of the United States Department of the interior...

NOTE: Not more than 4 corners, all in the same town and range, may be recorded on this certificate.

A. Description of original monument and accessories and/or subsequent restoration:

Table with columns: B-13, 1837, 1938, 1968, 1984, 1992, G.L.O. Notes, Witness Map, Records, L.C.R.C. #4009, L.C.R.C. #6437, Cathcart, K.C. Surveyor, Williams & Works, John Bueche, John Bueche, Set Post, Monument, Concrete Monument, Set K.C. Monument, K.C. Monument

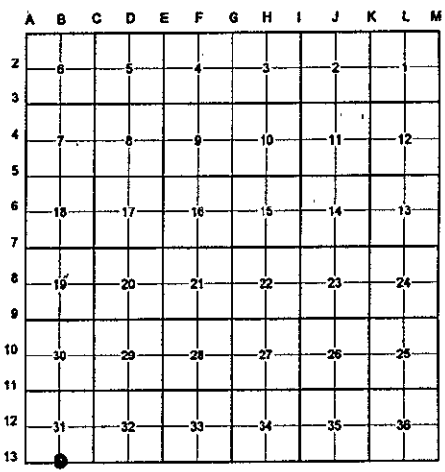

P.A. 345 1990 KENT COUNTY
PEER APPROVED 10/28/99
CHAIRMAN Randy Kolehouse

Note: This corner is not common with B-1, T9N, R9W.

This corner was originally approved by the Kent County Remonumentation Peer Group and monumented by John Bueche on 10/12/84 and was recorded per L.C.R.C. #4009.

B. Description of corner evidence found and/or method applied in restoring or reestablishing corner:

B-13 Found a Standard Kent County Monument 2' ± North of the North edge of 16 Mile Road (gravel) running Easterly and Westerly per L.C.R.C.'s #4009 and #6437 as set by John Bueche 132.00' East of the North 1/4 corner of Section 6, T9N, R9W, on line of the Northeast corner of Section 6 and the North 1/4 corner of Section 6.

L.C.R.C. #4009

L.C.R.C. #6437

K.C. Remon. tag & nail in W. side of 26" Oak N 25° W 33.70'
K.C. Remon. tag & nail in E. side of 24" dbl. Oak N 70° E 32.84'
K.C. Remon. tag & nail in NW side of 15" Oak S 80° E 44.45'
K.C. Remon. tag & nail in N. side of 18" Oak S 30° E 66.37'
K.C. Remon. tag & nail in W. side of 10" Oak S 10° E 58.83'
K.C. Remon. tag & nail in NW side of 20" Oak S 70° W 68.40'
4' N. of N. edge of gravel road


Cut nail in W side of 28" Oak N 25° W 33.70' (m. 33.63')
Cut nail in E side of 26" dbl. Oak N 70° E 32.84' (m. 32.79')
K.C. Remon. tag & nail in NW side of 16" Oak S 80° E 44.45' (m. 44.36')
K.C. Remon. tag & nail in N side of 20" Oak S 30° E 66.37' (m. 66.40')
K.C. Remon. tag & nail in W side of 12" Oak S 10° E 58.83' (m. 58.89')
K.C. Remon. tag & nail in NW side of 22" Oak S 70° W 68.40' (m. 68.32')
2' N of N edge of gravel road
K.C. Mon. (N 1/4 6, 9-9) East 132.00'

The selected location is accepted by me and is generally accepted by professional surveyors as the best available evidence of the position of the original corner.

C. Description of monument for corner and accessories established to perpetuate locating the position of the corner:

B-13 Standard Kent County Monument

- Nail & K.C. remon. tag on W side 28" Oak N 25° W 33.63'
Nail & K.C. remon. tag on E side 26" dbl. Oak N 70° E 32.79'
Nail & K.C. remon. tag on NW side 16" Oak S 80° E 44.36'
Nail & K.C. remon. tag on N side 20" Oak S 30° E 66.40'
Nail & K.C. remon. tag on W side 12" Oak S 10° E 58.89'
Nail & K.C. remon. tag on NW side 22" Oak S 70° W 68.32'
North edge of gravel road, South 2' ±
K.C. Mon. B-1, T9N, R9W, West 132.00'

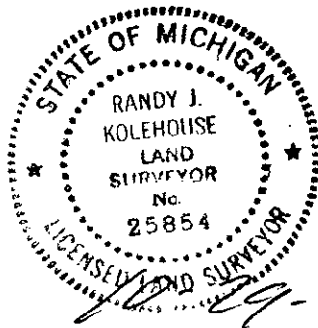

Signed by [Signature] Date [Signature]

WILLIAMS & WORKS

Surveyor's Michigan License No. 25854