

**LAND CORNER RECORDATION CERTIFICATE**  
**Filing Requirement of Act 74, Mich. P.A. 1970**

STATE OF MICHIGAN  
 COURT  
 RECEIVED FOR  
 93 SEP -9 AM 10:00

For corners in Kent (County) Located In: \_\_\_\_\_ Corner Code 11

1. Public Land Survey T 10N R 9W D-10  
 T \_\_\_\_\_ R \_\_\_\_\_  
 T \_\_\_\_\_ R \_\_\_\_\_  
 T \_\_\_\_\_ R \_\_\_\_\_

2. Property Controlling in Section S \_\_\_\_\_ T \_\_\_\_\_ R \_\_\_\_\_  
 S \_\_\_\_\_ T \_\_\_\_\_ R \_\_\_\_\_

3. Miscellaneous Property in Sec. S \_\_\_\_\_ T \_\_\_\_\_ R \_\_\_\_\_  
 S \_\_\_\_\_ T \_\_\_\_\_ R \_\_\_\_\_

4. Lot No. \_\_\_\_\_ Recorded Plat \_\_\_\_\_

5. Private Claims \_\_\_\_\_

REG. OF DEEDS  
 6840  
 Register of Deeds Stamp & File Number

A	B	C	D	E	F	G	H	I	J	K	L	M
2	6		5		4				2			
3												
4	7		8		9		10		11		12	
5												
6	18		17		16		15		14		13	
7												
8	19		20		21		22		23		24	
9												
10	30		28		28		27		26		25	
11												
12	31		32		33		34		35		36	
13												


I, Wallace E. Glaza in a field survey on August 3 1993  
do hereby certify that under requirements of P.A. 74, Michigan P.A. of 1970, the corner points mentioned in lines 1 and 2 above were in conformance with regulations and rules therefore as required in the current manual of survey instructions of the United States Department of the Interior, Bureau of Land Management or by a decree of a Court of Law and/or that the corner points mentioned in lines 3, 4 and 5 above were in conformance with the rules of the Michigan Board of Land Surveyors or by a Decree of a Court of Law; established, re-established, monumented, re-monumented, recovered, found as expressed below:

NOTE: Not more than 4 corners, all in the same town and range, may be recorded on this certificate.

A. Description of original monument and accessories and/or subsequent restoration:  
 No previous history.

B. Description of corner evidence found and/or method applied in restoring or reestablishing corner:  
 D-10 (Center of Section 29, T10N, R9W, Spencer Township, Kent County, Michigan)  
 Set standard 4" x 30" Harrison Monument at the intersection of the 1/4 lines.  
 Corner falls in remnants of E-W fence. Remnants of N-S fence East 5'±.  
 South 1/4 corner to center - 2653.05'  
 West 1/4 corner to center - 2642.77'  
 North 1/4 corner to center - 2647.35'  
 East 1/4 corner to center - 2669.58'

C. Description of monument for corner and accessories established to perpetuate locating the position of the corner  
 D-10 (Standard 4" x 30" Harrison Monument)  
 1) Nail and tag in N side 8" Aspen N90°E 32.52'  
 2) Nail and tag in W side 8" Hickory N15°E 21.84'  
 3) Nail and tag in N side 8" Cherry N60°W 15.41'  
 4) Nail and tag in W side 20" Willow S10°E 28.12'

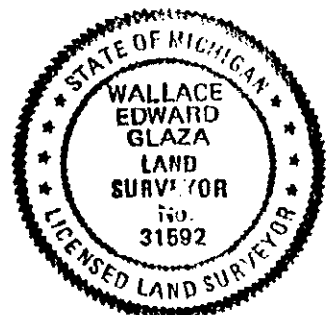

Signed by Wallace E. Glaza  
Glaza and Associates, Inc. 31592  
 Surveyor's Michigan License No.

Date Sept 1, 1993