

\$7.00
\$2.00

MAY 22 2000

LAND CORNER RECORDATION CERTIFICATE
Filing Requirement of Act 74, Mich. P.A. 1970
KENT COUNTY REMONUMENTATION

For corners in

SECTION


Kent (County)	Located in:	Spencer Township	Corner Code #
1. Public Land Survey	T 10N	R 9W	E-13
	T	R	
	T	R	
	T	R	
2. Property Controlling in Section	S	T	R
	S	T	R
3. Miscellaneous Property in Sec.	S	T	R
	S	T	R

STATE OF MICHIGAN
COUNTY OF KENT
RECEIVED FOR RECORD
1999 DEC - 8 AM 10:01
REG. OF DEEDS
11531
Register of Deeds Stamp & File Number

4. Lot No. _____, Recorded Plat _____
5. Private Claims _____

I, Randy Kolehouse, in a field survey on August 31 19 99, do hereby certify that under requirements of P.A. 74 Michigan P.A. of 1970, the corner points mentioned in lines 1 and 2 above were in conformance with regulations and rules therefore as required in the current manual of survey instructions of the United States Department of the Interior, Bureau of Land Management or by a decree of a Court of Law and/or that the corner points mentioned in lines 3, 4 and 5 above were in conformance with the rules of the Michigan Board of Land Surveyors or by a Decree of a Court of Law; established, re-established, monumented, re-monumented, recovered, found as expressed below:

NOTE: Not more than 4 corners, all in the same town and range, may be recorded on this certificate.

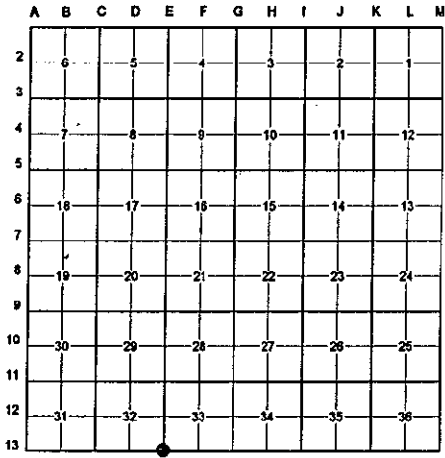

A. Description of original monument and accessories and/or subsequent restoration:

E-13	1837	G.L.O. Notes	Cathcart	Set Post
	1938	Witness Map	K.C. Surveyor	Iron
	1978	L.C.R.C. #1112	James A. Reda	"T" Iron
	1981	L.C.R.C. #1517	Williams & Works	Fnd. "T" Iron / Set K.C. Monument
	1992	L.C.R.C. #6467	John Bueche	K.C. Monument

P.A. 345 1990 KENT COUNTY

PEER APPROVED 10/28/99
CHAIRMAN [Signature]

Note: This corner is not common with E-1, T9N, R9W.

This corner was originally approved by the Kent County Remonumentation Peer Group and monumented by Williams & Works on 12/12/80 and was recorded per L.C.R.C. #1517.

B. Description of corner evidence found and/or method applied in restoring or reestablishing corner:

E-13 Found a Standard Kent County Monument 4' ± South of the C/L intersection of 16 Mile Road (gravel) running East and West and Wabasis Avenue (gravel) running North per L.C.R.C.'s #1517 and #6467 as set by Williams & Works in place of a "T" iron they found which checked L.C.R.C. #1112 and the K.C. Surveyor's records.

L.C.R.C. #1517

L.C.R.C. #6467

K.C.R. Tag & Nail in S. Side P. Pole N 70°E 98.82'
K.C.R. Tag & Nail in W. Side 40" Maple N 10°E 147.79'
K.C.R. Tag & Nail in S. Side 38" Oak N 55°W 118.89'
S.E. Cor. Hse. Fnd. N 50°W 163.55'
"X" on Top of Culvert S 35°W 21.16'
On C/L Gravel Rd. N.
4' S. of C/L Gravel Rd. E&W
Top of Mon. 6" +/- Below Gravel Rd.


Center 1' x 1' MBT Box N 70° W 85.25' (m. 85.11')
K.C. Remon. Tag & Nail in S side P. Pole N 70° E 100.98' (m. 100.80')
SE cor. hse. fnd. N 50° W 163.55' (m. 163.34')
"X" on top of culvert S 35° W 21.16' (m. 21.14')
On C/L of road N; 4' S of C/L E & W
K.C. Mon. (NE 5, 9-9) West 145.00'

The selected location is accepted by me and is generally accepted by professional surveyors as the best available evidence of the position of the original corner.

C. Description of monument for corner and accessories established to perpetuate locating the position of the corner:

E-13 Standard Kent County Monument

"X" cut top West end culvert S 35° W 21.14'
Nail & K.C. remon. tag on S side P. pole N 70° E 100.80'
Nail & K.C. remon. tag on W side 48" Maple N 10° E 147.71'
SE cor. fndn. Hse. N 50° W 163.34'
C/L 1' x 1' MBT box N 70° W 85.11'
C/L "X" of gravel roads running E-W & N, North 4' ±
K.C. Mon. E-1, T9N, R9W, West 145.08'

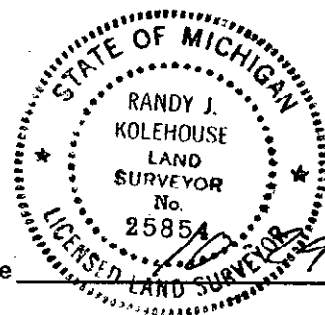

Signed by [Signature] Date 10-9-99

Surveyor's Michigan License No. 25854