

**LAND CORNER RECORDATION CERTIFICATE**  
**Filing Requirement of Act 74, Mich. P.A. 1970**

For corners in

Kent

(County)

Located In:

Corner Code *11*

- |                                       |                          |      |
|---------------------------------------|--------------------------|------|
| 1. Public Land Survey                 | T <u>10N</u> R <u>9W</u> | F-10 |
|                                       | T _____ R _____          |      |
|                                       | T _____ R _____          |      |
|                                       | T _____ R _____          |      |
| 2. Property Controlling in Section    | S _____ T _____ R _____  |      |
|                                       | S _____ T _____ R _____  |      |
| 3. Miscellaneous Property in Sec.     | S _____ T _____ R _____  |      |
|                                       | S _____ T _____ R _____  |      |
| 4. Lot No. _____, Recorded Plat _____ |                          |      |
| 5. Private Claims _____               |                          |      |

93 AUG 11 1993

6815

Register of Deeds Stamp & File Number

I, Wallace E. Glaza, in a field survey on August 4, 1993

do hereby certify that under requirements of P.A. 74, Michigan P.A. of 1970, the corner points mentioned in lines 1 and 2 above were in conformance with regulations and rules therefore as required in the current manual of survey instructions of the United States Department of the Interior, Bureau of Land Management or by a decree of a Court of Law and/or that the corner points mentioned in lines 3, 4 and 5 above were in conformance with the rules of the Michigan Board of Land Surveyors or by a Decree of a Court of Law; established, re-established, monumented, re-monumented, recovered, found as expressed below.

NOTE: Not more than 4 corners, all in the same town and range, may be recorded on this certificate.


A. Description of original monument and accessories and/or subsequent restoration  
 No previous history.

B. Description of corner evidence found and/or method applied in restoring or reestablishing corner:  
 F-10 (center of Section 28, T10N, R9W, Spencer Township, Kent County, Michigan)  
 Set standard 4" x 30" Harrison Monument at intersection of  $\frac{1}{4}$  lines.

- S  $\frac{1}{4}$  corner to center - 2667.23'
- W  $\frac{1}{4}$  corner to center - 2641.73'
- N  $\frac{1}{4}$  corner to center - 2653.40'
- E  $\frac{1}{4}$  corner to center - 2634.09'

C. Description of monument for corner and accessories established to perpetuate locating the position of the corner:  
 F-10 (standard 4" x 30" Harrison Monument)

- 1) Nail and tag in West side 38" Maple N15°E 101.63'
- 2) Nail and tag in North side 16" Oak N90°E 38.88'
- 3) Nail and tag in East side 8" Maple S15°E 44.55'
- 4) Nail and tag in NE side 48" Twin Maple N80°W 36.80'

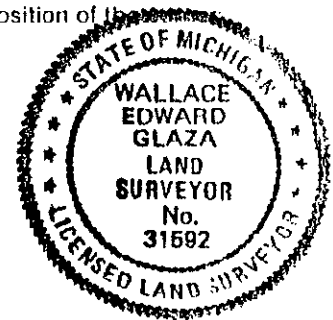

Signed by Wallace E. Glaza  
 Glaza and Associates, Inc. 31592  
 Surveyor's Michigan License No. \_\_\_\_\_

Date 8-9-93