

SURVEY &
REMONUMENTATION

\$7.00
\$2.00

MAY 22 2000

SECTION

LAND CORNER RECORDATION CERTIFICATE
Filing Requirement of Act 74, Mich. P.A. 1970
KENT COUNTY REMONUMENTATION

For corners in

Kent (County)	Located in: Spencer Township	Corner Code #
1. Public Land Survey	T <u>10N</u> R <u>9W</u>	<u>G-13</u>
	T _____ R _____	_____
	T _____ R _____	_____
	T _____ R _____	_____
2. Property Controlling in Section	S _____ T _____ R _____	_____
	S _____ T _____ R _____	_____
3. Miscellaneous Property in Sec.	S _____ T _____ R _____	_____
	S _____ T _____ R _____	_____

REG. OF DEEDS

[Signature]

STATE OF MICHIGAN
COUNTY OF KENT
RECEIVED FOR RECORD
1999 DEC - 8 AM 10: 02

11533

Register of Deeds Stamp & File Number

4. Lot No. _____, Recorded Plat _____
5. Private Claims _____

I, Randy Kolehouse, in a field survey on September 29 19 99, do hereby certify that under requirements of P.A. 74 Michigan P.A. of 1970, the corner points mentioned in lines 1 and 2 above were in conformance with regulations and rules therefore as required in the current manual of survey instructions of the United States Department of the Interior, Bureau of Land Management or by a decree of a Court of Law and/or that the corner points mentioned in lines 3, 4 and 5 above were in conformance with the rules of the Michigan Board of Land Surveyors or by a Decree of a Court of Law; established, re-established, monumented, re-monumented, recovered, found as expressed below:

NOTE: Not more than 4 corners, all in the same town and range, may be recorded on this certificate.

A. Description of original monument and accessories and/or subsequent restoration:

G-13	1837	G.L.O. Notes	Cathcart	Set Post
	N/A	Witness Map	K.C. Surveyor	N/A
	1981	L.C.R.C. #1619	Paul Van Kooten	1/2" Iron
	1982	L.C.R.C. #2908	Jonker Land Surveys	Fnd. 1/2" Iron / Set K.C. Monument
	1992	L.C.R.C. #6485	John Bueche	K.C. Monument

Note: This corner is not common with G-1, T9N, R9W.

This corner was originally approved by the Kent County Remonumentation Peer Group and monumented by Rob Jonker on 6/4/82 and was recorded per L.C.R.C. #2908.

B. Description of corner evidence found and/or method applied in restoring or reestablishing corner:

G-13 Found a Standard Kent County Monument on line of a tree row running West and North per L.C.R.C.'s #2908 and #6485 as set by Rob Jonker in place of a 1/2" iron he found which checked with L.C.R.C. #1619 and the K.C. Surveyor's records.

L.C.R.C. #2908

Remon. tag on W side 12" Oak S0°E 44.76'
Remon. tag on S side 10" Oak N20°W 21.23'
Remon. tag on SW side 14" Oak S45°E 9.84'
Remon. tag on W side 9" Oak N85°W 19.92'
Sq. spk. on W side 30" Maple N40°E 29.11'
Sq. spk. on E side 9" Oak S10°E 6.94'
Iron West 152.04'

L.C.R.C. #6485


Nail & K.C. Remon. Tag on E side 12" Oak S 10° E 6.96'
Remon. Tag on W side 12" Oak S 00° E 44.76' (m. 44.68')
Remon. Tag on S side 10" Oak N 20° W 21.23'
Remon. Tag on SW side 14" Oak S 45° E 9.84' (m. 9.87')
Remon. Tag on W side 9" Oak N 85° W 19.85'
Sq. spk. on W side 30" Maple N 40° E 29.11' (m. 29.16')
Sq. spk. on E side 9" Oak S 10° E 6.94' (m. 6.96')
K.C. Mon. (NE 4, 9-9) West 152.04'

The selected location is accepted by me and is generally accepted by professional surveyors as the best available evidence of the position of the original corner.

C. Description of monument for corner and accessories established to perpetuate locating the position of the corner:

G-13 Standard Kent County Monument


Nail & K.C. remon. tag on W side 14" Oak S 00° E 44.68'
Nail & K.C. remon. tag on W side 12" Oak N 20° W 21.23'
Nail & K.C. remon. tag on SW side 16" Oak S 45° E 9.87'
Nail & K.C. remon. tag on E side 10" Oak S 10° E 6.96'
Nail & K.C. remon. tag on W side 34" Maple N 40° E 29.16'
On tree row running W & N
K.C. Mon., G-7, T9N, R9W, West 152.04'

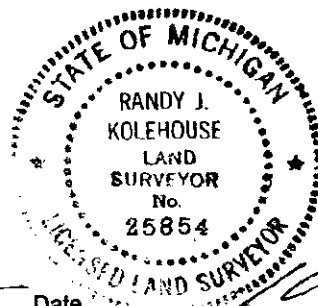

Signed by *Randy J. Kolehouse* Date 10-29-99

WILLIAMS & WORKS

Surveyor's Michigan License No. 25854

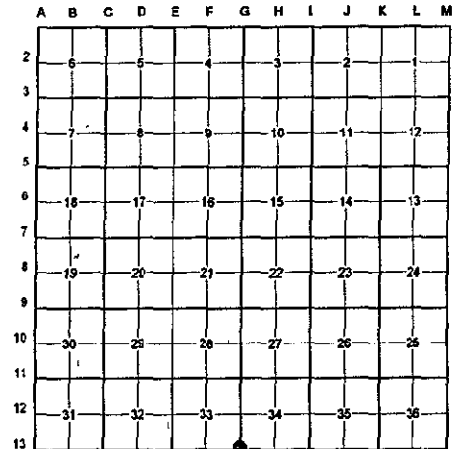

P.A. 345 1990 KENT COUNTY
PEER APPROVED 10/28/99
CHAIRMAN *[Signature]*