

1993

COMMISSION


Kent County Remonumentation LAND CORNER RECORDATION CERTIFICATE Filing Requirement of Act 74, Mich. P.A. 1970

For corners in

Form with fields for Kent (County), Located In, Corner Code #, and numbered sections 1-5 for survey details.

Stamp area containing the number 6789 and the text 'Register of Deeds Stamp & File Number'.

I, John C. Bueche, in a field survey on June, 19 93, do hereby certify that under requirements of P.A. 74, Michigan P.A. of 1970, the corner points mentioned in lines 1 and 2 above were in conformance with regulations and rules therefor as required in the current manual of survey instructions of the United States Department of the Interior, Bureau of Land Management or by a decree of a Court of Law and/or that the corner points mentioned in lines 3, 4 and 5 above were in conformance with the rules of the Michigan Board of Land Surveyors or by a Decree of a Court of Law, established, re-established, monumented, re-monumented, recovered, found as expressed below:

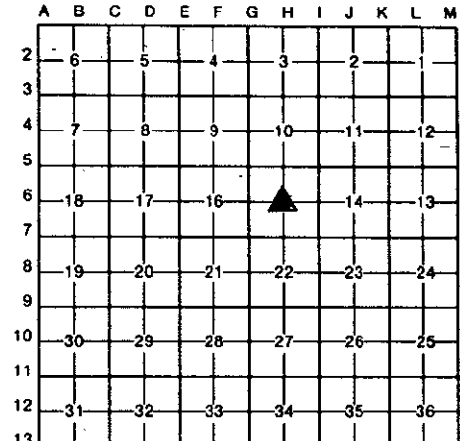


NOTE: Not more than 4 corners, all in the same town and range, may be recorded on this certificate.

A. Description of original monument and accessories and/or subsequent restoration: H-6 Nothing recorded W & W 1971 computed the position of the C 1/4, by setting the S 1/4 cor. half the dist. & intersecting the E-W 1/4 Lines with this line C 1/4 to W 1/4 2676.04' C 1/4 to E 1/4 2679.87' C 1/4 to N 2611.32'

B. Description of corner evidence found and/or method applied in restoring or reestablishing corner: H-6 Set cor. on the E & W 1/4 Line at mean bearing between the NW & W 1/4 cors. and the NE & E 1/4 cors. C 1/4 to W 1/4 2674.28' C 1/4 to W 1/4 2684.53' C 1/4 to N 2611.56'

C. Description of monument for corner and accessories established to perpetuate locating the position of the corner: H-6 Set Std. K.C. Mon. (Harrison 4" x 30") 8" above grade in swamp area Nail & K.C. Remon. Tag in N side 8" Pine S 70° W 47.52' Nail & K.C. Remon. Tag in NE side 6" Birch N 55° W 29.06' Nail & K.C. Remon. Tag in SE side 8" Maple N 30° E 34.57' Nail & K.C. Remon. Tag in W side 4" Birch S 50° E 14.23' Meas. by hand

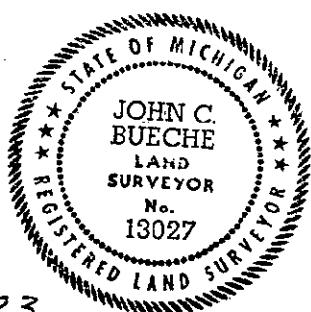

Signed by John C Bueche Surveyor's Michigan License No. 13027

Date June 10, 1993