

1993

COMMISSION

Kent County Remonumentation
LAND CORNER RECORDATION CERTIFICATE
Filing Requirement of Act 74, Mich. P.A. 1970

30 JUL 93 11:01

For corners in

Kent (County)	Located In:	Corner Code #
1. Public Land Survey	T <u>10N</u> R <u>9W</u>	H-9 (S <u>1/4</u> , 22) Spencer Twp.
	T _____ R _____	_____
	T _____ R _____	_____
	T _____ R _____	_____
2. Property Controlling in Section	S _____ T _____ R _____	_____
	S _____ T _____ R _____	_____
3. Miscellaneous Property in Sec.	S _____ T _____ R _____	_____
	S _____ T _____ R _____	_____

Handwritten signature

6798

Register of Deeds Stamp & File Number

- 4. Lot No. _____, Recorded Plat _____
- 5. Private Claims _____

	A	B	C	D	E	F	G	H	I	J	K	L	M
2	6	5	4	3	2	1							
3													
4	7	8	9	10	11	12							
5													
6	18	17	16	15	14	13							
7													
8	19	20	21	22	23	24							
9				▲									
10	30	29	28	27	26	25							
11													
12	31	32	33	34	35	36							
13													

I, John C. Bueche, in a field survey on March, 19 93, do hereby certify that under requirements of P.A. 74, Michigan P.A. of 1970, the corner points mentioned in lines 1 and 2 above were in conformance with regulations and rules therefore as required in the current manual of survey instructions of the United States Department of the Interior, Bureau of Land Management or by a decree of a Court of Law and/or that the corner points mentioned in lines 3, 4 and 5 above were in conformance with the rules of the Michigan Board of Land Surveyors or by a Decree of a Court of Law, established, re-established, monumented, re-monumented, recovered, found as expressed below.

NOTE: Not more than 4 corners, all in the same town and range, may be recorded on this certificate.

A. Description of original monument and accessories and/or subsequent restoration:


H-9 GLO notes
East on random 39.00 ch. Lake, offset South 5.50 ch., East 33.00 ch., North 5.50 ch., 80.18 ch. interest N-S Line 20 lks. N of post
West on corrected line 8.18' set post, swampy edge of Lake, 40.09 ch. set post on bank of Lake, 80.18 ch. Sec. cor.

B. Description of corner evidence found and/or method applied in restoring or reestablishing corner:

H-9 Set the cor. on Line between the SW cor. & the SE cor. of Sec. 22 and at the intersection of the N-S 1/4 Line produced N Using S 1/4, C 1/4, 1/8 cor. 13 30.18' N of C 1/4 & point 2472.87' N of C 1/4 cor. on C/L 18 Mile Road

C. Description of monument for corner and accessories established to perpetuate locating the position of the corner:

H-9 Set wit. Mon. 516.60' E of N 1/4 Sec. 27 on S Line Sec. 22
(See LCRC 6795)
Set wit. Mon. 916.76' W of N 1/4 Sec. 27 on S Line Sec. 22 (See LCRC 6796)
Set wit. Mon. 149.75' S of N 1/4 Sec. 27 on N-S 1/4 Line Sec. 27
(See LCRC 6797)
See Liber 255 page 16 for section survey of Sec. 22
See Liber 255 page 15 for section survey of Sec. 27

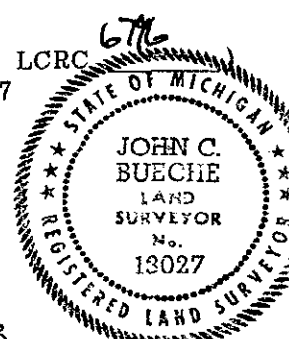

Signed by John C Bueche Date June 10, 1993

Surveyor's Michigan License No. 13027