

1993

COMMISSION

Kent County Remonumentation LAND CORNER RECORDATION CERTIFICATE Filing Requirement of Act 74, Mich. P.A. 1970


93 JUL 20 10:30

For corners in

Table with columns: Kent (County), Located In, Corner Code #. Rows include Public Land Survey, Property Controlling in Section, and Miscellaneous Property in Sec.

6788 Register of Deeds Stamp & File Number

4. Lot No. , Recorded Plat
5. Private Claims

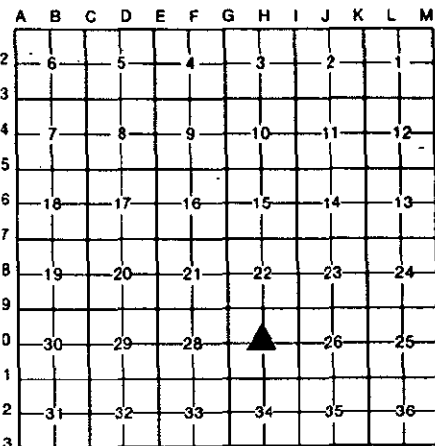

I, John C. Bueche, in a field survey on June 19 93 do hereby certify that under requirements of P.A. 74, Michigan P.A. of 1970, the corner points mentioned in lines 1 and 2 above were in conformance with regulations and rules therefore as required in the current manual of survey instructions of the United States Department of the Interior, Bureau of Land Management or by a decree of a Court of Law and/or that the corner points mentioned in lines 3, 4 and 5 above were in conformance with the rules of the Michigan Board of Land Surveyors or by a Decree of a Court of Law; established, re-established, monumented, re-monumented, recovered, found as expressed below:

NOTE: Not more than 4 corners, all in the same town and range, may be recorded on this certificate.

A. Description of original monument and accessories and/or subsequent restoration:

H-10 LCRC #614, Dec., 1973 "T" iron Spk. in S side 14" Hickory E 24.07' Spk. in SW side 10" Tw. Oak SE 34.85' PK nail N side PP WSW 63.80' CP iron W 33.00' CP iron E 33.00' W & W 1935 reference to C 1/4 1925, 1926, 1944, 1954, as corner as 1935 1968 set S 1/4 cor. holding SE cor. Lot 1 & existing C 1/4; also set C 1/4 by intersection of 1/4 lines this cor. is 2.5' S of previous C 1/4


See back

B. Description of corner evidence found and/or method applied in restoring or reestablishing corner:

H-10 Found 1/2" rerod As per above wit. Cor. is on N-S 1/4 Line using S 1/4 cor., C 1/4 cor., 1/8 cor. 1330.18' N of C 1/4 & PK 2472.87 N of C 1/4 18 Mile Road

C. Description of monument for corner and accessories established to perpetuate locating the position of the corner:

H-10 Replaced 1/2" rerod with Std. K.C. Mon. (Harrison 4" x 30") in gravel road 8" below grade Existing PK nail in N side PP S 85° W 63.80' Existing Spk. in N side 14" Ash N 75° W 27.73' Existing Spk. in SW side 12" Oak S 30° E 34.55' Nail & K.C. Remon. Tag in N side 16" Oak N 90° E 24.46' Nail & K.C. Remon. Tag in SE side 14" Oak N 55° E 54.22' C/L N-S gravel rd. W 2'± C/L E-W power line N 175'± Meas. by hand

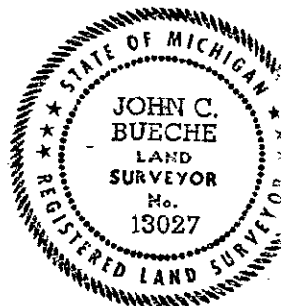

Signed by John C Bueche Date June 10, 1993 Surveyor's Michigan License No. 13027

PP SW 63.40'
14" Maple E 23.55'
24" Maple ESE 39.90'
18" Maple SSW 74.90'
In C/L N-S road