

1993

COMMISSION

Kent County Remonumentation
LAND CORNER RECORDATION CERTIFICATE
Filing Requirement of Act 74, Mich. P.A. 1970

50 JUN 20 10:30

For corners in


<u>Kent</u> (County)	Located In:	Corner Code #:
1. Public Land Survey	T <u>10N</u> R <u>9W</u>	I-6(E 1/4, 15) Spencer Twp.
	T _____ R _____	_____
	T _____ R _____	_____
	T _____ R _____	_____
2. Property Controlling in Section	S _____ T _____ R _____	_____
	S _____ T _____ R _____	_____
3. Miscellaneous Property in Sec.	S _____ T _____ R _____	_____
	S _____ T _____ R _____	_____
4. Lot No. _____, Recorded Plat _____		
5. Private Claims _____		

6787

Register of Deeds Stamp & File Number

I, John C. Bueche in a field survey on April, 1993

do hereby certify that under requirements of P.A. 74, Michigan P.A. of 1970, the corner points mentioned in lines 1 and 2 above were in conformance with regulations and rules therefore as required in the current manual of survey instructions of the United States Department of the Interior, Bureau of Land Management or by a decree of a Court of Law and/or that the corner points mentioned in lines 3, 4 and 5 above were in conformance with the rules of the Michigan Board of Land Surveyors or by a Decree of a Court of Law; established, re-established, monumented, re-monumented, recovered, found as expressed below:

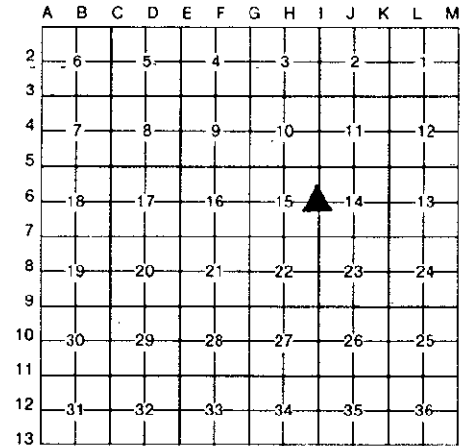

NOTE: Not more than 4 corners, all in the same town and range, may be recorded on this certificate.

A. Description of original monument and accessories and/or subsequent restoration:
I-6 LCRC #4924, Dec., 1988 MVK 1970

K.C. Mon. Set 1 1/2" pipe half way & on E
Nail & K.C. Remon. Tag in W side Line of Sec. 15
22" Pine S 87.80'

Nail & K.C. Remon. Tag in SW side
10" Maple S 35° W 62.75'

S edge creek N 90'±

W edge creek E 44'±

Cor. set by W & W 1968

Did not use for Section work in 1971, used MVK's iron

B. Description of corner evidence found and/or method applied in restoring or reestablishing corner:

I-6 Above K.C. Mon. (on W side creek) is about 134'± W & 30'±
N of iron set by MVK in 1970; found MVK iron half way & on Line,
on the E side of creek, no occupation @ either cor.

Recommend that the Mon. on W side be left in place & used
as a wit. mon. on the W side of creek


C. Description of monument for corner and accessories established to perpetuate locating the position of the corner:

I-6 Replaced 1-1/2" iron with Std. K.C. Mon. (Harrison 4" x 60") in swamp
6" - 8" above ground, set Carsonite post near mon.

K.C. Mon. N 77° 05' 56" W 137.30'

E edge of creek W 40'±

N edge of creek S 70±

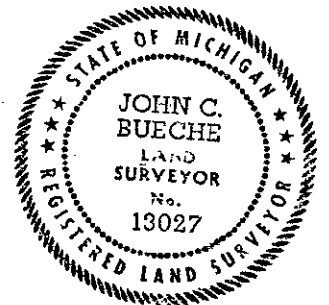

Signed by John C. Bueche

Date June 10, 1993

Surveyor's Michigan License No. 13027