

MAY 22 2000

\$7.00
\$2.00

SECTION

LAND CORNER RECORDATION CERTIFICATE
Filing Requirement of Act 74, Mich. P.A. 1970
KENT COUNTY REMONUMENTATION

For corners in

| Kent (County) | Located in: Spencer Township | Corner Code # |
|---------------------------------------|---------------------------------|---------------|
| 1. Public Land Survey | T <u>10N</u> R <u>9W</u> | <u>I-13</u> |
| | T _____ R _____ | _____ |
| | T _____ R _____ | _____ |
| | T _____ R _____ | _____ |
| 2. Property Controlling in Section | S _____ T _____ R _____ | _____ |
| | S _____ T _____ R _____ | _____ |
| 3. Miscellaneous Property in Sec. | S _____ T _____ R _____ | _____ |
| | S _____ T _____ R _____ | _____ |

REG. OF DEEDS

[Signature]


STATE OF MICHIGAN
COUNTY OF KENT
RECEIVED FOR RECORD
1999 DEC - 8 AM 10:02

11535

Register of Deeds Stamp & File Number

4. Lot No. _____, Recorded Plat _____
5. Private Claims _____

I, Randy Kolehouse, in a field survey on September 7 19 99, do hereby certify that under requirements of P.A. 74 Michigan P.A. of 1970, the corner points mentioned in lines 1 and 2 above were in conformance with regulations and rules therefore as required in the current manual of survey instructions of the United States Department of the Interior, Bureau of Land Management or by a decree of a Court of Law and/or that the corner points mentioned in lines 3, 4 and 5 above were in conformance with the rules of the Michigan Board of Land Surveyors or by a Decree of a Court of Law; established, re-established, monumented, re-monumented, recovered, found as expressed below:

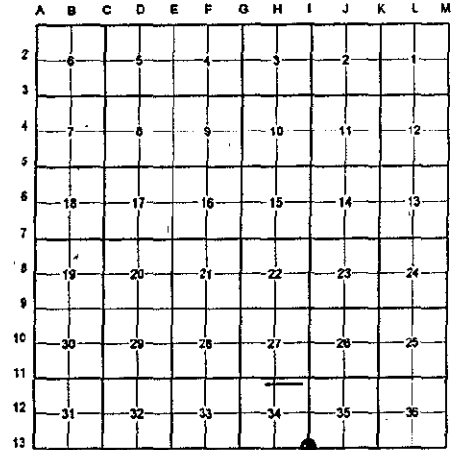

NOTE: Not more than 4 corners, all in the same town and range, may be recorded on this certificate.

A. Description of original monument and accessories and/or subsequent restoration:

| | | | | |
|------|------|----------------|--------------------|------------------------------------|
| I-13 | 1837 | G.L.O. Notes | Cathcart | Set Post |
| | 1977 | L.C.R.C. #1097 | Glaza & Associates | 1/2" Iron Rod |
| | 1980 | L.C.R.C. #1515 | Williams & Works | Fnd. 1/2" Iron / Set K.C. Monument |
| | 1989 | L.C.R.C. #5079 | John Bueche | K.C. Monument |
| | 1997 | L.C.R.C. #9931 | Kirk Breitels | K.C. Monument |

P.A. 345 1990 KENT COUNTY
PEER APPROVED 10/28/99
CHAIRMAN [Signature]

Note: This corner is not common with I-1, T9N, R9W.

This corner was originally approved by the Kent County Remonumentation Peer Group and monumented by Williams & Works on 12/12/80 and was recorded per L.C.R.C. #1515.

B. Description of corner evidence found and/or method applied in restoring or reestablishing corner:

I-13 Found a Standard Kent County Monument 5' ± North of the C/L of 16 Mile Road (bit.) running East and West and 88' ± East of the C/L of Lincoln Lake Road (bit.) running North and South per L.C.R.C.'s #1515, #5079, and #9931 as set by Williams & Works in place of a 1/2" iron they found which checked L.C.R.C. #1097.

L.C.R.C. #1515

L.C.R.C. #9931

Nail & K.C. Remon. Tag South Side 20" Oak S 65°E 147.34'
SW Cor Hse Block S 43°E 199.95'
Iron in Mon. Box (NW Cor Sec 2 T9N R9W) West 89.03'
C/L Blacktop Rd. South 5.0+/-


Nail & KC Remon. tag S. side 27" Oak S65°E 147.09' (m. 147.15')
Nail & KC Remon. tag S. side 27" Oak N65°E 150.09'
SW corner conc. block house S43°E 199.77'
Nail & KC Remon. tag E. side P. Pole N05°W 161.89'
Kent Co. Mon. in Mon. Box (I-1 Sec. 2-9-9) West 89.03'
C/L blackto road E-W - South 5+/-

The selected location is accepted by me and is generally accepted by professional surveyors as the best available evidence of the position of the original corner.

C. Description of monument for corner and accessories established to perpetuate locating the position of the corner:

I-13 Standard Kent County Monument

Nail & K.C. remon. tag on S face 27" Oak S 65° E 147.15'
Nail & K.C. remon. tag on S face 27" Oak N 65° E 150.09'
SW cor. conc. block hse. S 43° E 199.77'
Nail & K.C. remon. tag on E face P. pole N 05° W 161.89'
C/L of bit. road running E-W, South 5' ±
C/L of bit. road running N-S, West 88' ±
K.C. Mon. I-1, T9N, R9W, West 89.03'

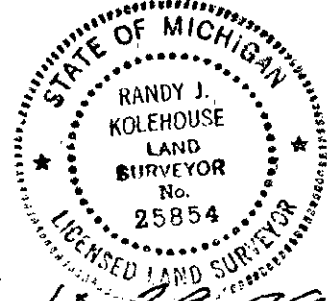

Signed by [Signature] Date 10-29-99

WILLIAMS & WORKS

Surveyor's Michigan License No. 25854