

SURVEY & REMONUMENTATION

1993

COMMISSION

Kent County Remonumentation  
LAND CORNER RECORDATION CERTIFICATE  
Filing Requirement of Act 74, Mich. P.A. 1970

RECEIVED  
93 JUL 23 11:10:30

For corners in

Kent (County)	Located In:	Corner Code #
1. Public Land Survey	T <u>10N</u> R <u>9W</u>	<u>J-8 (C 1/4, 23)</u> <u>Spencer Twp.</u>
	T _____ R _____	_____
	T _____ R _____	_____
	T _____ R _____	_____
2. Property Controlling in Section	S _____ T _____ R _____	_____
	S _____ T _____ R _____	_____
3. Miscellaneous Property in Sec.	S _____ T _____ R _____	_____
	S _____ T _____ R _____	_____
4. Lot No. _____, Recorded Plat _____		
5. Private Claims _____		

*John C. Bueche*  
REGISTERED LAND SURVEYOR

6784

Register of Deeds Stamp & File Number

I, John C. Bueche, in a field survey on June, 19 93, do hereby certify that under requirements of P.A. 74, Michigan P.A. of 1970, the corner points mentioned in lines 1 and 2 above were in conformance with regulations and rules therefore as required in the current manual of survey instructions of the United States Department of the Interior, Bureau of Land Management or by a decree of a Court of Law and/or that the corner points mentioned in lines 3, 4 and 5 above were in conformance with the rules of the Michigan Board of Land Surveyors or by a Decree of a Court of Law; established, re-established, monumented, re-monumented, recovered, found as expressed below:

	A	B	C	D	E	F	G	H	I	J	K	L	M
2	6	5	4	3	2	1							
3													
4	7	8	9	10	11	12							
5													
6	18	17	16	15	14	13							
7													
8	19	20	21	22	▲	24							
9													
10	30	29	28	27	26	25							
11													
12	31	32	33	34	35	36							
13													

**NOTE: Not more than 4 corners, all in the same town and range, may be recorded on this certificate.**

A. Description of original monument and accessories and/or subsequent restoration:


J-8 K.C. Wit. Map 1941	LCRC #5299, Dec., 1989
1 1/4" Iron	Capped 1/2" rebar
20" dbl. Ash NNE 121.7'	CP S 85° W 13.55'
16" Oak NE 28.6'	6" Oak N 55° E 48.75'
24" Maple E 64.90'	6" Oak S 50° E 52'

B. Description of corner evidence found and/or method applied in restoring or reestablishing corner:

J-8 Found capped 1/2" rebar on W edge of road  
As per above wit.  
Set by intersection of 1/4 Line  
1 1/4" iron was 5'± N & 6'± W, was removed

C. Description of monument for corner and accessories established to perpetuate locating the position of the corner:

J-8 Replace rebar with Std. K.C. Mon. (Harrison 4" x 30") 8" below grade  
Existing nail in S side PP S 85° W 13.55'  
Existing cut nail in N side 8" Oak N 55° E 46.75'  
Nail & K.C. Remon. Tag in N side 8" Poplar N 30° E-73.23'  
Nail & K.C. Remon. Tag in N side 10" Oak S 50° E 52.08'  
Mon. on W edge of N-S gravel rd.  
On tree line East  
Meas. by hand

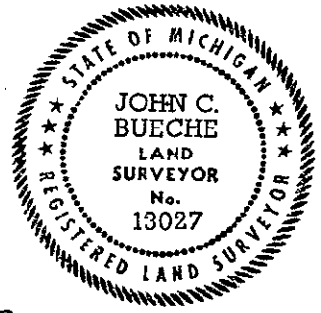

Signed by John C. Bueche Date June 10, 1993  
Surveyor's Michigan License No. 13027