

SURVEY & REMONUMENTATION

1993

COMMISSION Kent County Remonumentation LAND CORNER RECORDATION CERTIFICATE
Filing Requirement of Act 74, Mich. P.A. 1970

RECORDED
 JUL 23 11:10:30

For corners in

<u>Kent</u> <small>(County)</small>	Located In:	Corner Code #
1. Public Land Survey	T <u>10N</u> R <u>9W</u>	<u>J-10 (C 1/4, 26)</u> <u>Spencer Twp.</u>
	T _____ R _____	_____
	T _____ R _____	_____
	T _____ R _____	_____
2. Property Controlling in Section	S _____ T _____ R _____	_____
	S _____ T _____ R _____	_____
3. Miscellaneous Property in Sec.	S _____ T _____ R _____	_____
	S _____ T _____ R _____	_____

[Handwritten signature]
 REGISTERED

6785

Register of Deeds Stamp & File Number

4. Lot No. _____, Recorded Plat _____
 5. Private Claims _____

	A	B	C	D	E	F	G	H	I	J	K	L	M
2	6	5	4	3	2	1							
3													
4	7	8	9	10	11	12							
5													
6	18	17	16	15	14	13							
7													
8	19	20	21	22	23	24							
9													
10	30	29	28	27	▲	25							
11													
12	31	32	33	34	35	36							
13													

I, John C. Bueche, in a field survey on June, 19 93, do hereby certify that under requirements of P.A. 74, Michigan P.A. of 1970, the corner points mentioned in lines 1 and 2 above were in conformance with regulations and rules therefore as required in the current manual of survey instructions of the United States Department of the Interior, Bureau of Land Management or by a decree of a Court of Law and/or that the corner points mentioned in lines 3, 4 and 5 above were in conformance with the rules of the Michigan Board of Land Surveyors or by a Decree of a Court of Law; established, re-established, monumented, re-monumented, recovered, found as expressed below:

NOTE: Not more than 4 corners, all in the same town and range, may be recorded on this certificate.

A. Description of original monument and accessories and/or subsequent restoration:


J-10 W & W computed position of cor., it falls in the creek or swamp lands
 Set "T" iron 104.45' E of C 1/4 on the 1/4 Line

B. Description of corner evidence found and/or method applied in restoring or reestablishing corner:

J-10 Found "T" as per above ("T" iron is 103.79' E & 0.86' S of intersection of 1/4 Lines
 Set C 1/4 by intersection of 1/4 Lines, set wit. mon. 430.42' N of C 1/4 cor. on N-S 1/4 Line

C. Description of monument for corner and accessories established to perpetuate locating the position of the corner:

J-10 Set std. K.C. Mon. (Harrison 4" x 30") on high ground
 Nail & K.C. Remon. Tag in S side 12" Pine S 65° E 24.27'
 Nail & K.C. Remon. Tag in S side 8" Maple S 80° W 25.45'
 Nail & K.C. Remon. Tag in E side 18" Oak N 35° E 23.05'
 Nail & K.C. Remon. Tag in SW side 14" Oak N 35° W 31.48'
 Nail & K.C. Remon. Tag in W side 8" Oak S 0° W 18.55'
 C/L old 2 track N'ly & E'ly N 30'±
 N edge swamp South 100'±
 Meas. by hand

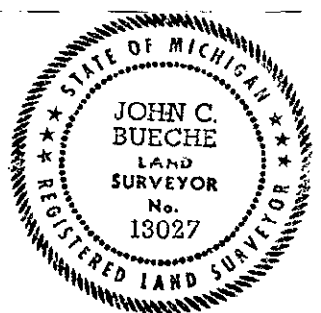

Signed by John C. Bueche Date June 10, 1993
 Surveyor's Michigan License No. 13027