

STATE OF MICHIGAN  
COUNTY OF KENT  
RECEIVED

**LAND CORNER RECORDATION CERTIFICATE**  
Filing Requirement of Act 74, Mich. P.A. 1970

89 SEP -7 PM 1:57

For corners in  
Kent  
(County)

Located In:	Corner Code #/
T <u>10N</u> R <u>9W</u>	<u>J-12</u>
T _____ R _____	_____
T _____ R _____	_____
T _____ R _____	_____
S _____ T _____ R _____	_____
S _____ T _____ R _____	_____
S _____ T _____ R _____	_____
S _____ T _____ R _____	_____

*Wallace E. Glaza*  
REG. OF DEEDS

6838

Register of Deeds Stamp & File Number

- Public Land Survey
- Property Controlling in Section
- Miscellaneous Property in Sec.
- Lot No. \_\_\_\_\_, Recorded Plat \_\_\_\_\_
- Private Claims \_\_\_\_\_

	A	B	C	D	E	F	G	H	I	J	K	L	M
2	6		5		4		3		2				
3													
4	7		8		9		10		11		12		
5													
6	18		17		16		15		14		13		
7													
8	19		20		21		22		23		24		
9													
10	30		29		28		27		26		25		
11													
12	31		32		33						36		
13													

I, Wallace E. Glaza, in a field survey on July 9, 19 93 do hereby certify that under requirements of P.A. 74, Michigan P.A. of 1970, the corner points mentioned in lines 1 and 2 above were in conformance with regulations and rules therefore as required in the current manual of survey instructions of the United States Department of the Interior, Bureau of Land Management or by a decree of a Court of Law and/or that the corner points mentioned in lines 3, 4 and 5 above were in conformance with the rules of the Michigan Board of Land Surveyors or by a Decree of a Court of Law; established, re-established, monumented, re-monumented, recovered, found as expressed below:

NOTE: Not more than 4 corners, all in the same town and range, may be recorded on this certificate.

- A. Description of original monument and accessories and/or subsequent restoration
- Williams & Works - June 1899 - Set stake and stone at intersection of  $\frac{1}{4}$  lines. No witnesses.
  - Williams & Works - Sept. 1940 - Found and accepted iron at downed fence for center of Section 35. Witnesses: 6" Oak SE 7.5', 10" Oak S 39.0', 12" Oak SE 44.3'. Dist center to  $W\frac{1}{4}$  - 2629.3', Dist center to  $S\frac{1}{4}$  - 2680.94'

B. Description of corner evidence found and/or method applied in restoring or reestablishing corner:

J-12 (Center of Section 35, T10N, R9W, Spencer Township, Kent County, Michigan)

Found iron pipe in downed N-S fence line and remnants of fence line to the East. 10" Oak only remaining witness. Iron pipe is 1.4' North and 36.7' West of intersection of  $\frac{1}{4}$  lines (holding midpoint distance for East  $\frac{1}{4}$  corner). Iron pipe has been used previously for both boundary surveys and plats. Accepted iron pipe as center of Section 35.


Replaced iron pipe with standard 4" x 30" Harrison Monument.

- South  $\frac{1}{4}$  to center - 2681.86'
- West  $\frac{1}{4}$  to center - 2626.87'
- North  $\frac{1}{4}$  to center - 2655.61'

C. Description of monument for corner and accessories established to perpetuate locating the position of the corner:

J-12 (Standard 4" x 30" Harrison Monument)

- Nail and tag in N side 10" Oak S80°W 12.76'
- Nail and tag in W side 12" Oak N10°E 37.77'
- Nail and tag in S side 6" Oak S80°E 19.44'
- Nail and tag in W side 16" Oak S00°W 38.96'

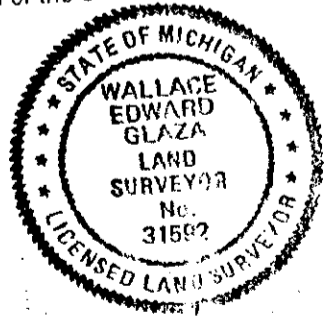

Signed by Wallace E. Glaza Date 8-12-93  
 Surveyor's Michigan License No. Glaza and Associates, Inc 31592