

MAY 22 2000

\$7.00
\$2.00

SECTION

LAND CORNER RECORDATION CERTIFICATE
Filing Requirement of Act 74, Mich. P.A. 1970

KENT COUNTY REMONUMENTATION

For corners in

Kent (County)	Located in:	Spencer Township	Corner Code #
1. Public Land Survey	T 10N	R 9W	J-13
	T	R	
	T	R	
	T	R	
2. Property Controlling in Section	S	T	R
	S	T	R
3. Miscellaneous Property in Sec.	S	T	R
	S	T	R

1999 DEC - 8 AM 10:02
 STATE OF MICHIGAN
 COUNTY OF KENT
 RECEIVED FOR RECORD
 REG. OF DEEDS


11536

Register of Deeds Stamp & File Number

4. Lot No. _____, Recorded Plat _____
 5. Private Claims _____

I, Randy Kolehouse, in a field survey on September 30 19 99, do hereby certify that under requirements of P.A. 74 Michigan P.A. of 1970, the corner points mentioned in lines 1 and 2 above were in conformance with regulations and rules therefore as required in the current manual of survey instructions of the United States Department of the Interior, Bureau of Land Management or by a decree of a Court of Law and/or that the corner points mentioned in lines 3, 4 and 5 above were in conformance with the rules of the Michigan Board of Land Surveyors or by a Decree of a Court of Law; established, re-established, monumented, re-monumented, recovered, found as expressed below:

NOTE: Not more than 4 corners, all in the same town and range, may be recorded on this certificate.

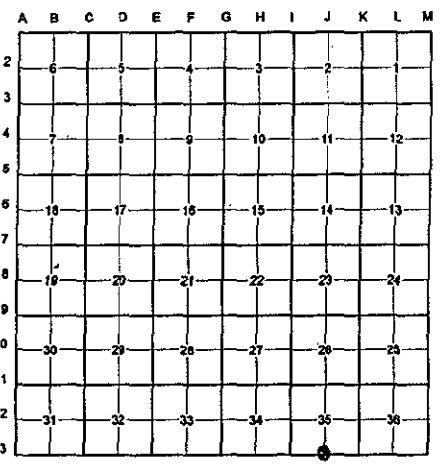

A. Description of original monument and accessories and/or subsequent restoration:

J-13	1837	G.L.O. Notes	Cathcart	Set Post
	1899-1948	Records	Williams & Works	Fnd. Stake, Set Iron, Set Mon.
	N/A	Witness Map	K.C. Surveyor	Iron
	1989	L.C.R.C. #5159	John Bueche	Fnd. Conc. Mon. / Set K.C. Monument
	1997	L.C.R.C. #9943	Kirk Breitels	K.C. Monument

P.A. 345 1990 KENT COUNTY
 PEER APPROVED 10/28/99
 CHAIRMAN John Bueche

Note: This corner is not common with J-1, T9N, R9W.

This corner was originally approved by the Kent County Remonumentation Peer Group and monumented by John Bueche on 5/22/89 and was recorded per L.C.R.C. #5159.

B. Description of corner evidence found and/or method applied in restoring or reestablishing corner:

J-13 Found a Standard Kent County Monument in concrete 1' ± West of edge of lake, on the C/L of 16 Mile Road (bit.) running West extended East per L.C.R.C.'s #5159 and #9943 as set by John Bueche in place of a concrete monument he found which checked the 1899 thru 1948 records of Williams & Works and the K.C. Surveyor's records.

L.C.R.C. #5159


L.C.R.C. #9943

K.C. Remon. Tag & Nail in N. side 18" Oak S 70° W 39.01'	Nail & KC Remon. tag N. side 20" Oak S70°W 39.01' (m. 39.18')
K.C. Remon. Tag & Nail in N. side 18" Oak S 50° W 28.95'	Nail & KC Remon. tag N. side 20" Oak S50°W 28.95' (m. 29.00')
K.C. Remon. Tag & Nail in S. side 26" Oak S 10° W 24.43'	Nail & KC Remon. tag S. side 28" Oak S10°W 24.43' (m. 24.93')
K.C. Remon. Tag & Nail in E. side 10" Sassafras N 65° W 69.30'	Nail & KC Remon. tag E. side 12" Sassafras N65°W 69.10'
Edge of Lake NE 1' +/-	Kent Co. Mon. (J-1, 9-9) West 64.78' (m. 64.72')
K.C. Mon. (J-1 9-9) West 64.78'	NE corner wood seawall S55°E 25.0' (m. 25.05')
	Edge of lake - NE 1'

The selected location is accepted by me and is generally accepted by professional surveyors as the best available evidence of the position of the original corner.

C. Description of monument for corner and accessories established to perpetuate locating the position of the corner:

- J-13 Standard Kent County Monument
- Nail & K.C. remon. tag on E side 12" Sassafras N 65° W 69.10'
- Nail & K.C. remon. tag on N side 20" Oak S 70° W 39.18'
- Nail & K.C. remon. tag on N side 23" Oak S 50° W 29.00'
- Nail & K.C. remon. tag on S'y side 32" Oak S 10° W 24.93'
- NE cor. wood seawall S 55° E 25.05'
- Water edge 1'+/- Easterly
- K.C. Mon. J-1, T9N, R9W, West 64.72'

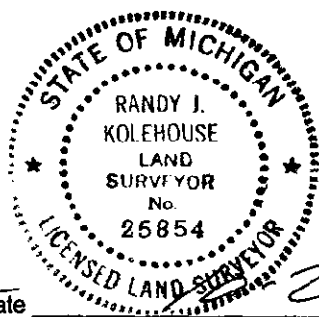

Signed by Randy J. Kolehouse Date 29-99
 WILLIAMS & WORKS
 Surveyor's Michigan License No. 25854