

LAND CORNER RECORDATION CERTIFICATE
Filing Requirement of Act 74, Mich. P.A. 1970

STATE OF MICHIGAN
 COUNTY OF KENT
 RECEIVED FOR RECORD

93 SEP -7 PM 1:55

For corners in

<u>Kent</u> (County)	Located In:	Corner Code #/
1. Public Land Survey	T <u>10N</u> R <u>9W</u>	<u>K-12</u>
	T _____ R _____	_____
	T _____ R _____	_____
	T _____ R _____	_____
2. Property Controlling in Section	S _____ T _____ R _____	_____
	S _____ T _____ R _____	_____
3. Miscellaneous Property in Sec.	S _____ T _____ R _____	_____
	S _____ T _____ R _____	_____

Eric J. Glaza
 REG. OF DEEDS

6837

Register of Deeds Stamp & File Number

4. Lot No. _____, Recorded Plat _____
 5. Private Claims _____

	A	B	C	D	E	F	G	H	I	J	K	L	M
2	6		5		4		3		2		1		
3													
4	7		8		9		10		11		12		
5													
6	13		17		16		15		14		13		
7													
8	19		20		21		22		23		24		
9													
10	30		29		28		27		26		25		
11													
12	31		32		33		34		35		36		
13													

I, Wallace E. Glaza, in a field survey on July 9, 19 93, do hereby certify that under requirements of P.A. 74, Michigan P.A. of 1970, the corner points mentioned in lines 1 and 2 above were in conformance with regulations and rules therefore as required in the current manual of survey instructions of the United States Department of the Interior, Bureau of Land Management or by a decree of a Court of Law and/or that the corner points mentioned in lines 3, 4 and 5 above were in conformance with the rules of the Michigan Board of Land Surveyors or by a Decree of a Court of Law; established, re-established, monumented, re-monumented, recovered, found as expressed below:

NOTE: Not more than 4 corners, all in the same town and range, may be recorded on this certificate.

A. Description of original monument and accessories and/or subsequent restoration:

Original government notes - corner falls in lake (Half Mile Lake)

B. Description of corner evidence found and/or method applied in restoring or reestablishing corner:


K-12 2 positions established (corners fall in Half Mile Lake)

1) For SE 1/4, Sec 35 & SW 1/4, Sec 36 - mathematical 1/4 corner established by extending the East line of Lakeland Oaks Plat (Liber 69, Page 13) North to a point which is equidistant from the new corner of Sec 36 and the SW corner of Section 36.

2) For NE 1/4, Sec 35 & NW 1/4, Sec 36 - mathematical 1/4 corner established by holding previously established West line of the NW 1/4 of Sec 36 and projecting it South to a point which is equidistant from the NW corner of Sec 36 and the SW corner of Sec 36.

C. Description of monument for corner and accessories established to perpetuate locating the position of the corner:

- See LCRC No. 6836 for North witness monument.
- See LCRC No. 6835 for East witness monument.
- See LCRC No. 6834 for South witness monument.
- See LCRC No. 6833 for West witness monument.

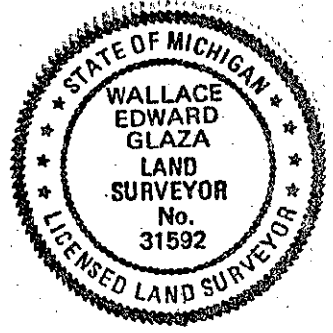

Signed by Wallace E. Glaza Date 8-12-93
 Glaza and Associates, Inc. 31592
 Surveyor's Michigan License No. _____