

**KENT COUNTY REMONUMENTATION
LAND CORNER RECORDATION CERTIFICATE
Filing Requirement of Act 74, Mich. P.A. 1970**

STATE OF MICHIGAN
COUNTY OF KENT
RECEIVED FOR RECORD

93 OCT -4 PH 1:53

Lucy Bond
REG. OF DEEDS

6848

Register of Deeds Stamp & File Number

For corners in Kent (County) Located In: Spencer Township Corner Code ##

1. Public Land Survey	T <u>10N</u> R <u>9W</u>	<u>L-6 (Gen. Sec 13)</u>
	T _____ R _____	_____
	T _____ R _____	_____
	T _____ R _____	_____
2. Property Controlling in Section	S _____ T _____ R _____	_____
	S _____ T _____ R _____	_____
3. Miscellaneous Property in Sec.	S _____ T _____ R _____	_____
	S _____ T _____ R _____	_____

4. Lot No. _____, Recorded Plat _____

5. Private Claims _____

	A	B	C	D	E	F	G	H	I	J	K	L	M
2	6	5	4	3	2	1							
3													
4	7	8	9	10	11	12							
5													
6	18	17	16	15	14	13							
7													
8	19	20	21	22	23	24							
9													
10	30	29	28	27	26	25							
11													
12	31	32	33	34	35	36							
13													

I, _____, in a field survey on _____, 19____, do hereby certify that under requirements of P.A. 74, Michigan P.A. of 1970, the corner points mentioned in lines 1 and 2 above were in conformance with regulations and rules therefore as required in the current manual of survey instructions of the United States Department of the Interior, Bureau of Land Management or by a decree of a Court of Law and/or that the corner points mentioned in lines 3, 4 and 5 above were in conformance with the rules of the Michigan Board of Land Surveyors or by a Decree of a Court of Law; established, re-established, monumented, re-monumented, recovered, found as expressed below:

NOTE: Not more than 4 corners, all in the same town and range, may be recorded on this certificate.

A. Description of original monument and accessories and/or subsequent restoration:


-6 No recorded L.C.R.C. to date
 1957 Williams & Works establish Center by using S 1/8 Cor., NE 1/4 & W 1/4 line position matched centerline of road as shown on highway plan #H-89.
 Center Section - S 1/8 cor., NE 1/4 = 1330.55'
 Center Section - S 1/8 cor., NW 1/4 = 1322.5'
 Center Section - iron on N-S 1/4 line @ S. shore Bass Lake = 1059.6'
 Center Section - iron @ W 1/4 cor. = 2645.0'
 1960 K.C. Witness Map - 1" iron 15" Oak E=SE 111.05' 18" Oak W-SW 69.25'

B. Description of corner evidence found and/or method applied in restoring or reestablishing corner:

L-6
 Found 1/2" re-rod at ± centerline X of Bass Lake Ave. & Steffensen Rd.
 30" Oak S70°W +69'
 24" Oak S75°E +111'
 Re-rod is 6.12' N of line between W 1/4 cor. and E 1/4 cor.
 Also found 2" iron pipe below rerod/1" iron pipe below 2" iron pipe

C. Description of monument for corner and accessories established to perpetuate locating the position of the corner:

L-6 Center of Section 13
 Replaced rerod & iron pipes with Std. KC Mon. (4"x30") encased in concrete flush with pavement
 At intersection of Bass Lake Ave. and Steffensen St.
 On C/L of Bass Lake Ave. to South
 C/L of gravel road to West South 5'
 C/L of gravel road to East South 7'
 Set nail & KC tag in SE sde Tw. 30" Oak S70°W 69.05'
 Set nail & KC tag in SE sde P.Pole N60°E 71.19'
 Set nail & KC tag in N sde Tw. 24" Oak S75°E 111.87'
 Set nail & KC tag in SW sde 10" Poplar S30°E 68.64'

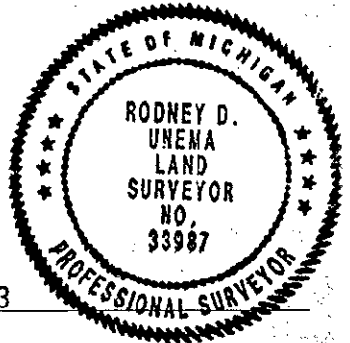

Signed by Rodney D. Unema Date September 10, 1993
 Surveyor's Michigan License No. 33987

Note: See Survey L 257 P 36 for Survey Map

