

LAND CORNER RECORDATION CERTIFICATE
Filing Requirement of Act 74, Mich. P.A. 1970

STATE OF MICHIGAN
 COUNTY OF KENT
 RECEIVED

93 SEP -7 PM 1:05

For corners in

<u>Kent</u> <small>(County)</small>	Located In:	Corner Code: <u>L-12</u>
1. Public Land Survey	T <u>10N</u> R <u>9W</u>	
	T _____ R _____	
	T _____ R _____	
	T _____ R _____	
2. Property Controlling in Section	S _____ T _____ R _____	
	S _____ T _____ R _____	
3. Miscellaneous Property in Sec.	S _____ T _____ R _____	
	S _____ T _____ R _____	
4. Lot No. _____, Recorded Plat _____		
5. Private Claims _____		

REG. OFF.

6839

Register of Deeds Stamp & File Number

I, Wallace E. Glaza, in a field survey on July 9, 19 93 do hereby certify that under requirements of P.A. 74, Michigan P.A. of 1970, the corner points mentioned in lines 1 and 2 above were in conformance with regulations and rules therefore as required in the current manual of survey instructions of the United States Department of the Interior, Bureau of Land Management or by a decree of a Court of Law and/or that the corner points mentioned in lines 3, 4 and 5 above were in conformance with the rules of the Michigan Board of Land Surveyors or by a Decree of a Court of Law; established, re-established, monumented, re-monumented, recovered, found as expressed below:

NOTE: Not more than 4 corners, all in the same town and range, may be recorded on this certificate.

A	B	C	D	E	F	G	H	I	J	K	L	M
2	6	5	4	3	2	1						
3												
4	7	8	9	10	11	12						
5												
6	18	17	16	15	14	13						
7												
8	19	20	21	22	23	24						
9												
10	30	29	28	27	26	25						
11												
12	31	32	33	34	35							
13												

A. Description of original monument and accessories and/or subsequent restoration:

Kent County Road Commission witnesses (1941)

- Iron 4" Oak W 13.4'
- 4" Oak NW 18.2'
- 3" Oak NE 12.7'
- 8" Oak SE 17.5'

B. Description of corner evidence found and/or method applied in restoring or reestablishing corner:

L-12 (Center of Section 36, T10N, R9W, Spencer Township, Kent County, Michigan)

Found iron as above. Iron is 0.86' North and 5.69' East of intersection of $\frac{1}{4}$ lines (holding midpoint distance for West $\frac{1}{4}$ corner). Accepted iron as center of Section 36.


Replace iron with standard 4" x 30" Harrison Monument.

- North $\frac{1}{4}$ corner to center - 2644.16'
- East $\frac{1}{4}$ corner to center - 2652.52'
- South $\frac{1}{4}$ corner to center - 2651.28'

C. Description of monument for corner and accessories established to perpetuate locating the position of the corner:

L-12 (Standard 4" x 30" Harrison Monument)

- 1) Nail and tag in S side 6" Cherry N70°E 28.78'
- 2) Nail and tag in NE side 16" Oak S20°E 13.45'
- 3) Nail and tag in S side 16" Oak S60°W 48.85'
- 4) Nail and tag in E side 14" Oak N25°W 27.38'
- 5) Centerline East-West 2-track South 50'±

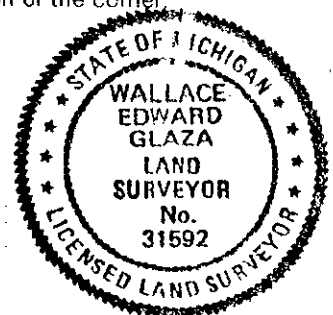

Signed by Wallace E. Glaza
 Glaza and Associates, Inc. 31592
 Surveyor's Michigan License No.

Date 8-12-93