

\$7.00  
\$2.00

MAY 22 2000

LAND CORNER RECORDATION CERTIFICATE  
Filing Requirement of Act 74, Mich. P.A. 1970  
KENT COUNTY REMONUMENTATION

For corners in

SECTION

Kent (County)	Located in:	Spencer Township	Corner Code #
1. Public Land Survey	T 10N	R 9W	L-13
	T	R	
	T	R	
	T	R	
2. Property Controlling in Section	S	T	R
	S	T	R
3. Miscellaneous Property in Sec.	S	T	R
	S	T	R

REG. OF DEEDS

*[Signature]*

STATE OF MICHIGAN  
COUNTY OF KENT  
RECEIVED FOR RECORD  
1999 DEC - 8 AM 10:02

11538

Register of Deeds Stamp & File Number

4. Lot No. \_\_\_\_\_, Recorded Plat \_\_\_\_\_  
5. Private Claims \_\_\_\_\_

I, Randy Kolehouse, in a field survey on September 29 19 99, do hereby certify that under requirements of P.A. 74 Michigan P.A. of 1970, the corner points mentioned in lines 1 and 2 above were in conformance with regulations and rules therefore as required in the current manual of survey instructions of the United States Department of the interior, Bureau of Land Management or by a decree of a Court of Law and/or that the corner points mentioned in lines 3, 4 and 5 above were in conformance with the rules of the Michigan Board of Land Surveyors or by a Decree of a Court of Law; established, re-established, monumented, re-monumented, recovered, found as expressed below:

NOTE: Not more than 4 corners, all in the same town and range, may be recorded on this certificate.

A. Description of original monument and accessories and/or subsequent restoration:

L-13	1837	G.L.O. Notes	Cathcart	Set Post
	1941	Witness Map	K.C. Surveyor	Iron
	1984	L.C.R.C. #4011	John Bueche	Fnd. Irons / Set K.C. Monument
	1989	L.C.R.C. #5089	John Bueche	K.C. Monument
	1997	L.C.R.C. #9969	Kirk Breitels	K.C. Monument

Note: This corner is not common with L-1, T9N, R9W.

This corner was originally approved by the Kent County Remonumentation Peer Group and monumented by John Bueche on 10/11/84 and was recorded per L.C.R.C. #4011.

B. Description of corner evidence found and/or method applied in restoring or reestablishing corner:

L-13 Found a Standard Kent County Monument on the C/L of 16 Mile Road (bit.) running East and West per L.C.R.C.'s #4011, #5089, and #9969 as set by John Bueche in place of a "T" iron he found over an old bent iron which checked the K.C. Surveyor's records.

L.C.R.C. #5089

Remon Tag & Nail in S side 18" Pine N 55° W 66.27'  
Remon Tag & Nail in W side dbl 26" Oak N 0° E 36.18'  
Remon Tag & Nail in W side 14" Oak S 40° E 58.13'  
Remon Tag & Nail in W side 14" Oak S 15° W 40.68'  
Remon Tag & Nail in W side 14" Pine N 55° E 64.34'  
Cut nail in E side 14" Pine S 55° W 63.09'  
On C/L blacktop road E-W  
K.C. Mon L-1, T9N, R9W, West 13.85'

L.C.R.C. #9969


Nail & KC Remon. tag S. side 20" stump N55°W 66.23' (m. 66.27')  
Nail & KC Remon. tag W. side dbl. 26" Oak N00°E 36.18' (m. 36.19')  
Nail & KC Remon. tag W. side 16" Oak S40°E 58.13' (m. 58.12')  
Nail & KC Remon. tag W. side 16" Oak S15°W 40.70' (m. 40.73')  
Nail & KC Remon. tag W. side 16" Pine N55°E 64.34'  
Nail & KC Remon. tag E. side 16" Pine S55°W 63.09' (m. 63.12')  
On C/L blacktop road E-W  
K.C. Mon. (L-1, T9N, R9W) - West 13.83' (m. 13.85')

The selected location is accepted by me and is generally accepted by professional surveyors as the best available evidence of the position of the original corner.

C. Description of monument for corner and accessories established to perpetuate locating the position of the corner:

L-13 Standard Kent County Monument

- Nail & K.C. remon. tag on S side 20" stump N 55° W 66.27'
- Nail & K.C. remon. tag on W side 26" Oak N 00° E 36.19'
- Nail & K.C. remon. tag on W side 16" Pine N 55° E 64.34'
- Nail & K.C. remon. tag on W side 16" Oak S 40° E 58.12'
- Nail & K.C. remon. tag on W side 16" Oak S 14° W 40.73'
- Nail & K.C. remon. tag on E side 16" Pine S 55° W 63.12'
- On C/L of bit. road running E-W
- K.C. Mon. L-1, T9N, R9W, West 13.85'

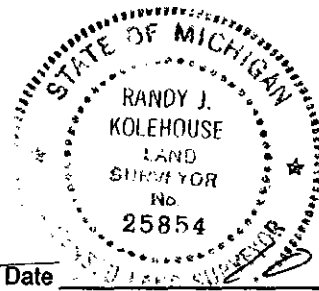

Signed by *Randy J. Kolehouse* Date 10-29-99

WILLIAMS & WORKS

Surveyor's Michigan License No. 25854

