

SURVEY & REMONUMENTATION

MAY 09 1996

COMMISSION *Other* LAND CORNER RECORDATION CERTIFICATE Filing Requirement of Act 74, Mich. P.A. 1970

STATE OF MICHIGAN
COUNTY OF KENT
RECEIVED FOR

93 SEP -7 PM 1:05

For corners in

Kent

(County)

Located In:

Corner Code #11

1. Public Land Survey

T 10N R 9W

North witness monument to K-12

T _____ R _____

T _____ R _____

T _____ R _____

2. Property Controlling in Section

S _____ T _____ R _____

Other Code

S _____ T _____ R _____

3. Miscellaneous Property in Sec.

S _____ T _____ R _____

#13

S _____ T _____ R _____

4. Lot No. _____, Recorded Plat _____

5. Private Claims _____

6836
Register of Deeds Stamp & File Number

	A	B	C	D	E	F	G	H	I	J	K	L	M
2	6	5	4	3	2	1							
3													
4	7	8	9	10	11	12							
5													
6	18	17	16	15	14	13							
7													
8	19	20	21	22	23	24							
9													
10	30	29	28	27	26	25							
11													
12	31	32	33	34	35	36							
13													


I, Wallace E. Glaza, in a field survey on July 9, 1993 do hereby certify that under requirements of P.A. 74, Michigan P.A. of 1970, the corner points mentioned in lines 1 and 2 above were in conformance with regulations and rules therefore as required in the current manual of survey instructions of the United States Department of the Interior, Bureau of Land Management or by a decree of a Court of Law and/or that the corner points mentioned in lines 3, 4 and 5 above were in conformance with the rules of the Michigan Board of Land Surveyors or by a Decree of a Court of Law; established, re-established, monumented, re-monumented, recovered, found as expressed below:

NOTE: Not more than 4 corners, all in the same town and range, may be recorded on this certificate.

A. Description of original monument and accessories and/or subsequent restoration:
No previous history.

B. Description of corner evidence found and/or method applied in restoring or reestablishing corner:
North witness monument to K-12, T10N, R9W, Spencer Township, Kent County, Michigan.
Set standard 4" x 30" Harrison Monument 14' North of waters edge of Half Mile Lake on a straight line between the Northwest corner of Section 36 and the $\frac{1}{4}$ corner as established for the NW $\frac{1}{4}$ of Section 36 and NE $\frac{1}{4}$ of Section 35.
Witness corner is 2028.11 feet South of the Northwest corner of Section 36.

C. Description of monument for corner and accessories established to perpetuate locating the position of the corner:
North witness monument to K-12 (4" x 30" standard Harrison Monument)
1) Nail and tag in S side 20" Maple S75°E 23.14'
2) Nail and tag in N side 10" Maple N75°W 5.96'
3) SE corner of house at 13771 Hudson N60°E 34.97'
4) SW corner of house at 13771 Hudson N10°E 31.00'
5) Nail and tag in S side 18" Maple S55°E 47.59'

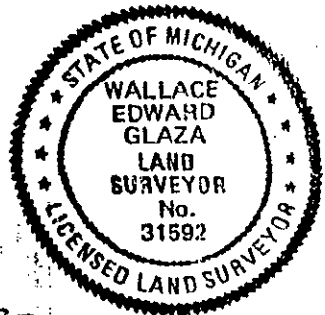

Signed by Wallace E. Glaza
Glaza and Associates, Inc.
Surveyor's Michigan License No. 31592

Date 8-12-93