

MAY 22 2000

\$7.00  
\$2.00

SECTION

**LAND CORNER RECORDATION CERTIFICATE**  
Filing Requirement of Act 74, Mich. P.A. 1970  
KENT COUNTY REMONUMENTATION


For corners in

<u>Kent</u> (County)	Located in:	Nelson Township	Corner Code #
1. Public Land Survey	T <u>10N</u>	R <u>10W</u>	<u>C-13</u>
	T _____	R _____	_____
	T _____	R _____	_____
	T _____	R _____	_____
2. Property Controlling in Section	S _____	T _____	R _____
	S _____	T _____	R _____
3. Miscellaneous Property in Sec.	S _____	T _____	R _____
	S _____	T _____	R _____

REG. OF DEEDS  
*[Signature]*  
1999 DEC - 8 AM 10:00  
STATE OF MICHIGAN  
COUNTY OF KENT  
RECEIVED FOR RECORD  
**11514**  
Register of Deeds Stamp & File Number

4. Lot No. \_\_\_\_\_, Recorded Plat \_\_\_\_\_  
5. Private Claims \_\_\_\_\_

I, Randy Kolehouse, in a field survey on January 25 19 99, do hereby certify that under requirements of P.A. 74 Michigan P.A. of 1970, the corner points mentioned in lines 1 and 2 above were in conformance with regulations and rules therefore as required in the current manual of survey instructions of the United States Department of the Interior, Bureau of Land Management or by a decree of a Court of Law and/or that the corner points mentioned in lines 3, 4 and 5 above were in conformance with the rules of the Michigan Board of Land Surveyors or by a Decree of a Court of Law; established, re-established, monumented, re-monumented, recovered, found as expressed below:

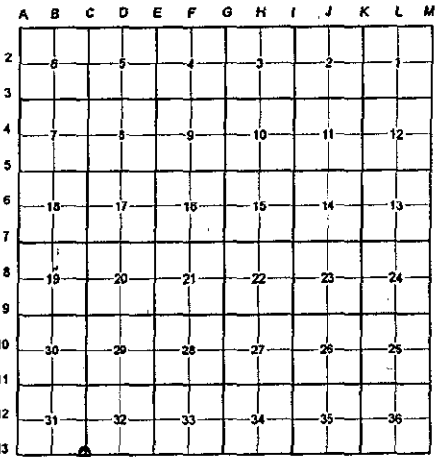

**NOTE:** Not more than 4 corners, all in the same town and range, may be recorded on this certificate.

A. Description of original monument and accessories and/or subsequent restoration:

C-13	1837	G.L.O. Notes	Cathcart	Set Post
	1938	Witness Map	K.C. Surveyor	Conc. Monument
	1986	L.C.R.C. #4447	Randy Kolehouse	Fnd. Conc. Monument / Set K.C. Monument
	1993	L.C.R.C. #6678	John Bueche	K.C. Monument

P.A. 345 1990 KENT COUNTY  
PEER APPROVED 10/28/99  
CHAIRMAN [Signature]

Note: This corner is not common with C-1, T9N, R10W.

This corner was originally approved by the Kent County Remonumentation Peer Group and monumented by Randy Kolehouse in May of 1986 and was recorded per L.C.R.C. #4447.

B. Description of corner evidence found and/or method applied in restoring or reestablishing corner:

C-13 Found a Standard Kent County Monument on the C/L of Ritchie Avenue (bit.) running North, 1' + South of the C/L of 16 Mile Road (bit.) running East and West, and 110' ± West of Ritchie Avenue (bit.) running South per L.C.R.C.'s #4447 and #6678 as set by Randy Kolehouse over the top of a concrete monument which checked the K.C. Surveyor's records.

L.C.R.C. #4447

L.C.R.C. #6678

Nail & K.C. Remon. tag in SW side P.Pole N 40° W 68.31'  
Nail & K.C. Remon. tag in N. side 14" Pine S 60° W 59.42'  
Nail & K.C. Remon. tag in E. side 18" Pine S 45° E 111.09'  
K.C. Mon. at the NE cor. sec. 6 T 9 N R 10 W East 112.00'

Nail & K.C. Remon. Tag in SW side PP N 40° W 68.84' (m. 69.85')  
Nail & K.C. Remon. Tag top of fence post S 75° E 140.54' (m. 140.60')  
Nail & K.C. Remon. Tag in N side 16" Pine S 60° W 59.37' (m. 59.42')  
Nail & K.C. Remon. Tag in E side 20" Pine S 45° E 111.09' (m. 111.05')  
SE cor. block bldg. fnd. N 40° E 163.56' (m. 163.54')  
K.C. Mon. NE 6 (9-10) West 112.00' (m. 112.26')  
On C/L bit. E-W; C/L bit. N, W 1'+/-  
Meas. by EDM

The selected location is accepted by me and is generally accepted by professional surveyors as the best available evidence of the position of the original corner.

C. Description of monument for corner and accessories established to perpetuate locating the position of the corner:

C-13 Standard Kent County Monument

Nail & K.C. remon. tag on SW side P. pole N 40° W 69.85'  
Nail & K.C. remon. tag on C/L 1' wood cor. fence post S 75° E 140.60'  
Nail & K.C. remon. tag on N side 16" Pine S 50° W 59.42'  
Nail & K.C. remon. tag on E side 22" Pine S 45° E 111.05'  
SE cor. block bldg. fndn. N 40° E 163.54'  
K.C. Mon., C-1, T9N, R10W, East 112.26'

C/L of bit. road running E-W, North 1' ±  
On C/L of bit. road running N  
C/L of bit. road running S, East 110' ±

Signed by Randy J. Kolehouse Date 10-27-99

WILLIAMS & WORKS

Surveyor's Michigan License No. 25854

